



TEL

# Testing Evaluation Laboratories, Inc.

2002 Wood Court Suite 1 – Plant City, FL 33563

Phone: 813-754-9887

ASTM E 1886-05 / ASTM E 1996-06  
Missile Level "D" (Includes Wind Zone 4)

## TEST REPORT SUMMARY

### Test Report Issued To:

Fleetwood Windows and Doors  
1 Fleetwood Way  
Corona, CA 92879

3300 GLACIER SLIDING GLASS DOORS

Title of Test	Results		
	Specimens 3, 4 and 5 240.00 x 120.00 – OXXO	Specimen 6 180.00 x 120.00 - OXO	Specimen 8 180.00 x 120.00 - OOX
Impact	Pass	Pass	Pass
Fatigue Load Cycling	+50.0/- 50.0 psf	+50.0/- 50.0 psf	+35.0/- 35.0 psf

Reference should be made to Report No. TEL 01991014 for complete test specimen description and data. For corresponding data regarding AAMA/WDMA/CSA 101/I.S./2/A440-08 (A440S1-09) reference should be made to Report No. TEL 01991013.

For Testing Evaluation Laboratories, Inc.



Vivian K. Wright

Vivian K. Wright,  
President



# Testing Evaluation Laboratories, Inc.

2002 Wood Court Suite 1 – Plant City, FL 33563

Phone: 813-754-9887

## TEST RESULTS

IAS Lab Certification Number: TL-299

Report No: TEL 01991014

Test Dates: January 16, 2014

through March 18, 2014

Report Date: March 21, 2014

### Issued to:

Fleetwood Windows and Doors  
One Fleetwood Way  
Corona, CA 92879

**Project Summary:** Testing Evaluation Laboratories, Inc. (TEL) was contracted by Fleetwood Windows and Doors to perform tests on the 3300 Glacier Sliding Glass Door at TEL's Plant City, FL test facility.

**Test specimen descriptions and results are reported herein.**

**Test Specifications:** The test specimens were evaluated in accordance with the following:

ASTM E 1886-05 / ASTM E 1996-06  
Missile Level "D" (Includes Wind Zone 4)

### Test Specimen Description:

**Series / Model:** 3300 Glacier Sliding Glass Door

**Type:** Aluminum Sliding Glass Doors

**Overall Size:** 240.00" x 120.00" – Specimens 3, 4 and 5 - OXXO

180.00" x 120.00" – Specimen 6 - OXO

180.00" x 120.00" – Specimen 8 - OOX

**Daylight Opening:** 54.75 " x 112.75" – Specimens 3, 4 and 5 (End Panels)

54.63 " x 112.75" – Specimens 3, 4 and 5 (Center Panels)

55.06" x 112.75" – Specimen 6 (All Panels)

55.06" x 112.75" – Specimen 8 (All Panels)

**Glazing Detail:** Laminated Monolithic Glass – (Specimens 3, 4 and 5)

Insulated Laminated Glass – (Specimens 6 and 8)

(See attached drawing for details)

**Frame Material:** Aluminum

**Finish:** Mill Finish

**For Tested Elevation, Vertical Cross Sections, Horizontal Cross Sections, Components, Frame Anchoring, Glazing Detail and Bill of Materials See Attached Drawing #L-7112, #L-7113, and #L-7114**

## IMPACT AND CYCLING TESTS

### Specimen 3 – 240.0" x 120.0" Aluminum Sliding Glass Door (OXXO)

#### ASTM E1886-05/1996-06 – Large Missile Impact (2 x 4 Southern Yellow Pine)

Cond. Temp Of Specimen	Missile Level	Missile Weight	Missile Length	Muzzle Distance From Specimen
76°F	D	9.0 lbs, 1 oz	8'-1/4"	17'1"

Impact Location	Results	X - Measurement	Y - Measurement	Speed
1	Pass	132.0"	11.0"	49.7 fps
2	Pass	154.0"	61.0"	50.1 fps
3	Pass	211.0"	60.5"	50.1 fps
4	Pass	190.0"	10.5"	49.9 fps
5	Pass	182.0"	60.0"	49.9 fps

Orientation of Missile at Impact was within +/-5° of horizontal.  
 None of the impacts penetrated the specimens.  
 "X" measurement is from the left edge of test specimen.  
 "Y" measurement is from the bottom edge of test specimen.

#### ASTM E1886-05/1996-06 – Fatigue Load Cycling      Design Pressure +50.0 psf / -50.0 psf

Positive % of Test Load	Positive Pressure Range (psf)	Number Of Cycles	Average Cycle Time (Sec)
20% to 50%	10.0 to 25.0	3500	2.46
0% to 60%	0.0 to 30.0	300	2.49
50% to 80%	25.0 to 40.0	600	1.92
30% to 100%*	15.0 to 50.0	100	2.86

Negative % of Test Load	Negative Pressure Range (psf)	Number Of Cycles	Average Cycle Time (Sec)
30% to 100%*	15.0 to 50.0	50	2.51
50% to 80%	25.0 to 40.0	1050	1.81
0% to 60%	0.0 to 30.0	50	2.25
20% to 50%	10.0 to 25.0	3350	1.95

\*Panel deflected 2.75" from original plane at 100% Positive load and 4.00" from original plane at 100% Negative load. At the completion of cycles the door panel was operable. There were no tears in the film. In our opinion, the tape and film used to seal for air leakage did not influence the results of the test.

Jarrett Wright and James Hayhurst, Test Technicians

Mfg Observers – Joe Zammitt

## IMPACT AND CYCLING TESTS

### Specimen 4 – 240.0" x 120.0" Aluminum Sliding Glass Door (OXXO)

ASTM E1886-05/1996-06 – Large Missile Impact (2 x 4 Southern Yellow Pine)

Cond. Temp Of Specimen	Missile Level	Missile Weight	Missile Length	Muzzle Distance From Specimen
76°F	D	9.0 lbs, 1 oz	8'-1/4"	17'1"

Impact Location	Results	X - Measurement	Y - Measurement	Speed
1	Pass	132.0"	10.5"	49.9 fps
2	Pass	153.75"	61.0"	49.8 fps
3	Pass	211.25"	61.0"	50.0 fps
4	Pass	190.0"	11.0"	49.9 fps
5	Pass	181.75"	60.0"	50.1 fps

Orientation of Missile at Impact was within +/-5° of horizontal.  
 None of the impacts penetrated the specimens.  
 "X" measurement is from the left edge of test specimen.  
 "Y" measurement is from the bottom edge of test specimen.

ASTM E1886-05/1996-06 – Fatigue Load Cycling      Design Pressure +50.0 psf / -50.0 psf

Positive % of Test Load	Positive Pressure Range (psf)	Number Of Cycles	Average Cycle Time (Sec)
20% to 50%	10.0 to 25.0	3500	2.35
0% to 60%	0.0 to 30.0	300	2.24
50% to 80%	25.0 to 40.0	600	2.05
30% to 100%*	15.0 to 50.0	100	2.78

Negative % of Test Load	Negative Pressure Range (psf)	Number Of Cycles	Average Cycle Time (Sec)
30% to 100%*	15.0 to 50.0	50	3.00
50% to 80%	25.0 to 40.0	1050	2.06
0% to 60%	0.0 to 30.0	50	2.72
20% to 50%	10.0 to 25.0	3350	2.22

\*Panel deflected 2.75" from original plane at 100% Positive load and 4.13" from original plane at 100% Negative load. At the completion of cycles the door panel was operable. There were no tears in the film. In our opinion, the tape and film used to seal for air leakage did not influence the results of the test.

Jarrett Wright and James Hayhurst, Test Technicians

Mfg Observers – Joe Zammitt

## IMPACT AND CYCLING TESTS

### Specimen 5 – 240.0" x 120.0" Aluminum Sliding Glass Door (OXXO)

#### ASTM E1886-05/1996-06 – Large Missile Impact (2 x 4 Southern Yellow Pine)

Cond. Temp Of Specimen	Missile Level	Missile Weight	Missile Length	Muzzle Distance From Specimen
76°F	D	9.0 lbs, 1 oz	8'-1/4"	17'1"

Impact Location	Results	X - Measurement	Y - Measurement	Speed
1	Pass	120.50"	54.00"	49.7 fps
2	Pass	154.00"	61.00"	50.1 fps
3	Pass	175.00"	110.00"	49.8 fps
4	Pass	182.00"	62.00"	50.0 fps
5	Pass	210.00"	62.00"	50.1 fps
6	Pass	232.00"	110.00"	49.8 fps

Orientation of Missile at Impact was within +/- 5° of horizontal.  
 None of the impacts penetrated the specimens.  
 "X" measurement is from the left edge of test specimen.  
 "Y" measurement is from the bottom edge of test specimen.

#### ASTM E1886-05/1996-06 – Fatigue Load Cycling      Design Pressure +50.0 psf / -50.0 psf

Positive % of Test Load	Positive Pressure Range (psf)	Number Of Cycles	Average Cycle Time (Sec)
20% to 50%	10.0 to 25.0	3500	2.44
0% to 60%	0.0 to 30.0	300	2.44
50% to 80%	25.0 to 40.0	600	2.25
30% to 100%*	15.0 to 50.0	100	2.47

Negative % of Test Load	Negative Pressure Range (psf)	Number Of Cycles	Average Cycle Time (Sec)
30% to 100%*	15.0 to 50.0	50	2.52
50% to 80%	25.0 to 40.0	1050	2.16
0% to 60%	0.0 to 30.0	50	2.15
20% to 50%	10.0 to 25.0	3350	1.80

\*Panel deflected 2.63" from original plane at 100% Positive load and 3.38" from original plane at 100% Negative load.  
 At the completion of cycles the door panel was operable. There were no tears in the film. In our opinion, the tape and film used to seal for air leakage did not influence the results of the test.

Jarrett Wright and James Hayhurst, Test Technicians

Mfg Observers – Joe Zammitt

## IMPACT AND CYCLING TESTS

### Specimen 6 – 180.0" x 120.0" Aluminum Sliding Glass Door (OXO)

#### ASTM E1886-05/1996-06 – Large Missile Impact (2 x 4 Southern Yellow Pine)

Cond. Temp Of Specimen	Missile Level	Missile Weight	Missile Length	Muzzle Distance From Specimen
74°F	D	9.0 lbs, 3 oz	8'-0"	17'0"

Impact Location	Results	X - Measurement	Y - Measurement	Speed
1	Pass	111.00"	10.00"	50.0 fps
2	Pass	94.00"	61.00"	49.8 fps
3	Pass	121.00"	60.00"	50.1 fps

Orientation of Missile at Impact was within +/- 5° of horizontal.  
 None of the impacts penetrated the specimens.  
 "X" measurement is from the left edge of test specimen.  
 "Y" measurement is from the bottom edge of test specimen.

#### ASTM E1886-05/1996-06 – Fatigue Load Cycling      Design Pressure +50.0 psf / -50.0 psf

Positive % of Test Load	Positive Pressure Range (psf)	Number Of Cycles	Average Cycle Time (Sec)
20% to 50%	10.0 to 25.0	3500	2.22
0% to 60%	0.0 to 30.0	300	2.15
50% to 80%	25.0 to 40.0	600	2.31
30% to 100%*	15.0 to 50.0	100	2.78

Negative % of Test Load	Negative Pressure Range (psf)	Number Of Cycles	Average Cycle Time (Sec)
30% to 100%*	15.0 to 50.0	50	2.93
50% to 80%	25.0 to 40.0	1050	2.52
0% to 60%	0.0 to 30.0	50	2.79
20% to 50%	10.0 to 25.0	3350	2.28

\*Panel deflected 3.00" from original plane at 100% Positive load and 4.25" from original plane at 100% Negative load.  
 At the completion of cycles the door panel was operable. There were no tears in the film. In our opinion, the tape and film used to seal for air leakage did not influence the results of the test.

Jarrett Wright and James Hayhurst, Test Technicians

Mfg Observers – Joe Zammitt

## IMPACT AND CYCLING TESTS

### Specimen 8 – 180.0" x 120.0" Aluminum Sliding Glass Door (OOX)

#### ASTM E1886-05/1996-06 – Large Missile Impact (2 x 4 Southern Yellow Pine)

Cond. Temp Of Specimen	Missile Level	Missile Weight	Missile Length	Muzzle Distance From Specimen
75°F	D	9.0 lbs, 3 oz	8'-0"	17'0"

Impact Location	Results	X - Measurement	Y - Measurement	Speed
1	Pass	59.00"	60.00"	50.1 fps
2	Pass	168.00"	11.00"	50.1 fps
3	Pass	146.00"	62.00"	49.9 fps
Orientation of Missile at Impact was within +/- 5° of horizontal. None of the impacts penetrated the specimens. "X" measurement is from the left edge of test specimen. "Y" measurement is from the bottom edge of test specimen.				

#### ASTM E1886-05/1996-06 – Fatigue Load Cycling

Design Pressure +35.0 psf / -35.0 psf

Positive % of Test Load	Positive Pressure Range (psf)	Number Of Cycles	Average Cycle Time (Sec)
20% to 50%	7.0 to 17.5	3500	1.76
0% to 60%	0.0 to 21.0	300	2.64
50% to 80%	17.5 to 28.0	600	1.28
30% to 100%*	10.5 to 35.0	100	2.51

Negative % of Test Load	Negative Pressure Range (psf)	Number Of Cycles	Average Cycle Time (Sec)
30% to 100%*	10.5 to 35.0	50	2.37
50% to 80%	17.5 to 28.0	1050	1.42
0% to 60%	0.0 to 21.0	50	2.49
20% to 50%	7.0 to 17.5	3350	1.72

\*Panel deflected 2.13" from original plane at 100% Positive load and 2.50" from original plane at 100% Negative load. At the completion of cycles the door panel was operable. There were no tears in the film. In our opinion, the tape and film used to seal for air leakage did not influence the results of the test.

Jarrett Wright and James Hayhurst, Test Technicians

Mfg Observers – Joe Zammitt

### Conditions, Terms, and General Notes Regarding These Tests

The product tested **Has Been** compared to the detailed drawing, bill of materials and fabrication information supplied by the client so named herein. Our analysis, which includes dimensional and component description comparisons, indicate the tested product and engineering information supplied by the client **"Are Equivalent"**. The report and representative samples will be retained for four years from the date of initial test.

These test results were obtained by employing all requirements of the designated test methods with no Deviations unless explicitly noted in test report. The test results and specimen supplied for testing are in compliance with the reference.

The test results are specific to the product tested by this laboratory and of the sample supplied by the client named herein, and they relate to no other product either manufactured by the client, a fabricator of the client or of the client or of installed field performance.

This test report does not constitute certification of this product, but only that the above test results were obtained using the designated test methods and they indicate compliance with the performance requirements (paragraphs as listed) of the above referenced specifications.

Testing Evaluation Laboratories, Inc. makes no opinions or endorsements regarding this product and its performance. This report may not be reproduced or quoted in partial form without the expressed written approval of Testing Evaluation Laboratories, Inc.

Testing Evaluation Laboratories, Inc.'s letter, reports, its name or insignia or mark are for the exclusive use of the client so named herein and any other use is strictly prohibited. The report, letters and the name of Testing Evaluation Laboratories, Inc., its seal or mark shall not be used in any circumstance to the general public or in any advertising.

Limitation of liability: Due diligence was used in performing the tests and reporting the results. By acceptance of this report, this client agrees to hold harmless and indemnify Testing Evaluation Laboratories, Inc., its employees, sub-contractors, officers and owners against all claims and demands of any kind whatsoever, which arise out of or in any manner connected with the performance of work referred to herein.

Testing Evaluation Laboratories, Inc.

A handwritten signature in blue ink that reads "Vivian K. Wright".

Vivian K. Wright,  
President


**Revision Log**

Rev No.	Date	Page(s)	Revision(s)
0	3/21/2014	NA	Original Report Issue

## TABLE OF CONTENTS

TABLE OF CONTENTS	
SHEET #	DESCRIPTION
1	Table of contents
2	Test elevation
3	Horizontal cross sections
4	Vertical cross sections
5	Sill meeting stile block details
6	Frame anchoring
7	Components
8	Components and glazing detail
9	Bill of materials




Testing Evaluation Laboratories Inc  
Specimen Complies with Drawing  
Deviations Noted - TEL # 01991014  
Date 3/11/04 Verified by Wm

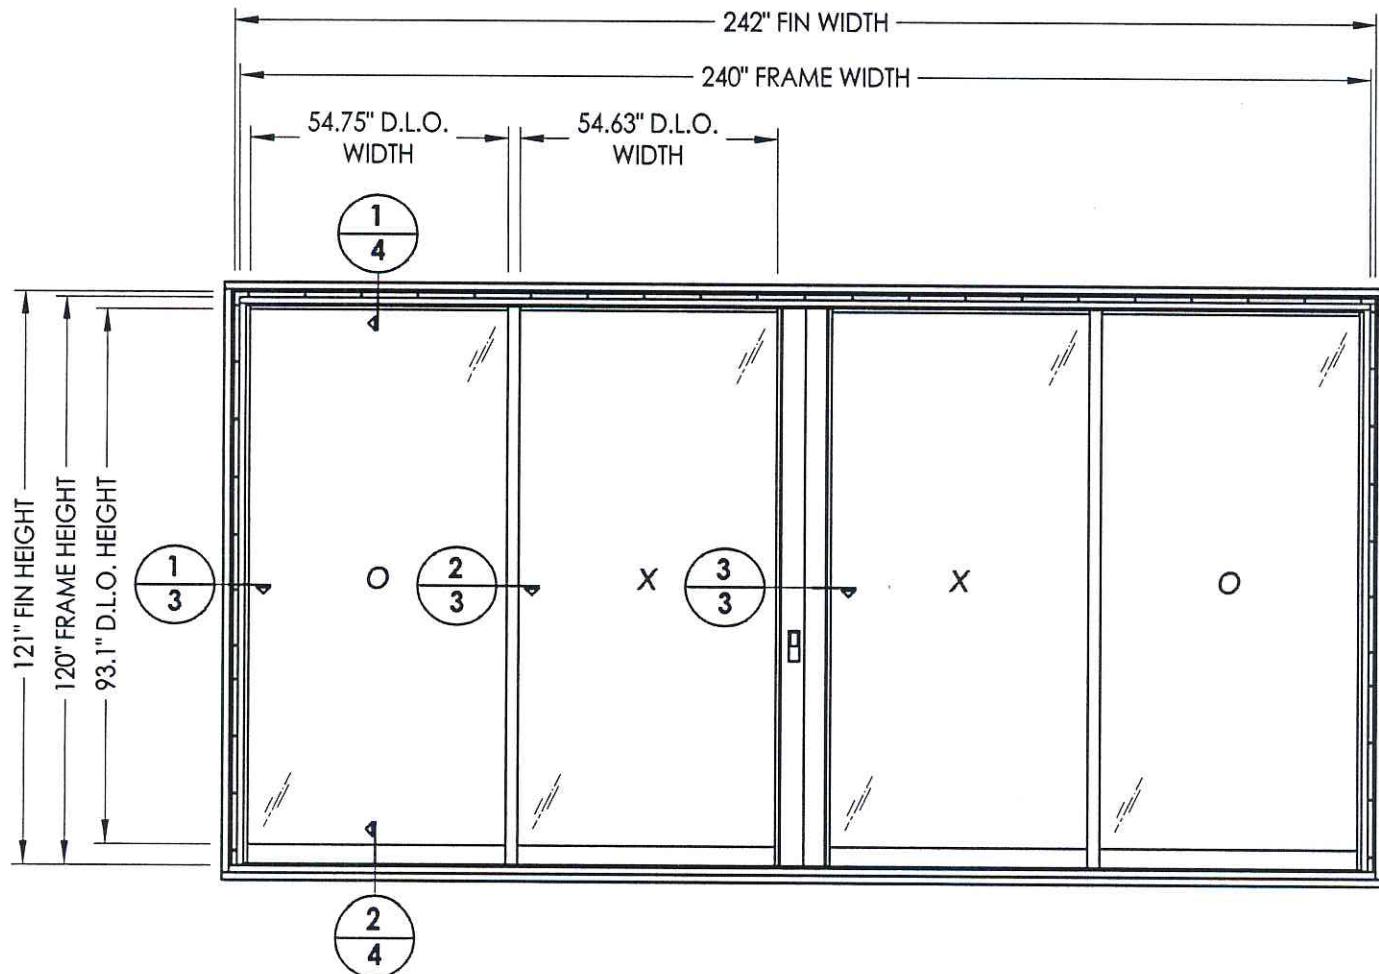

Testing Evaluation Laboratories Inc  
Specimen Complies with Drawing  
Deviations Noted - TEL # 01991014  
Date 3/21/14 Verified by John




DATE:	1/21/14
SCALE:	N.T.S.
DWG. BY:	JK
CHK. BY:	LFS
DRAWING NO.:	L-7113

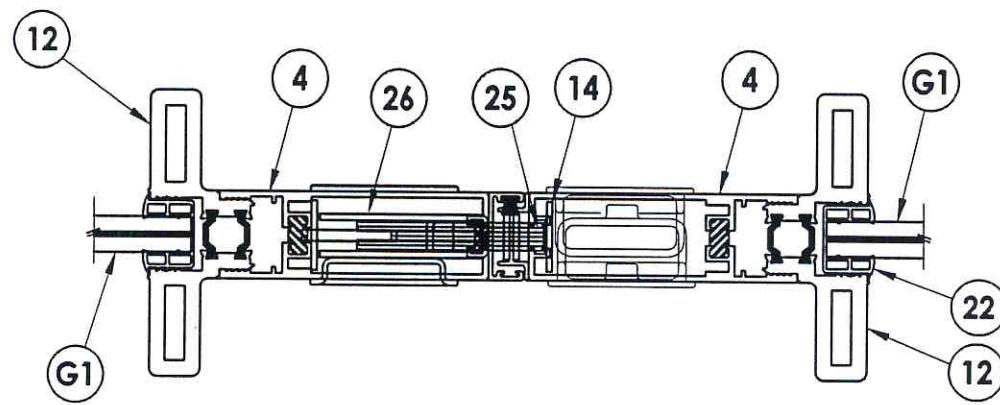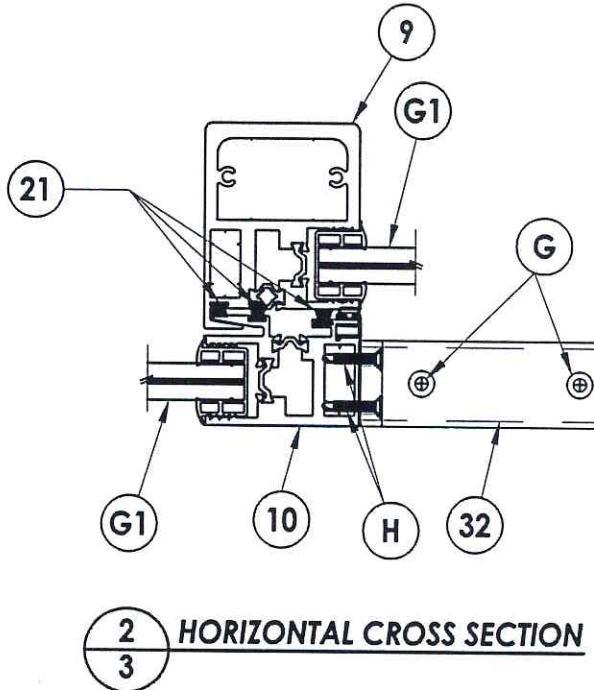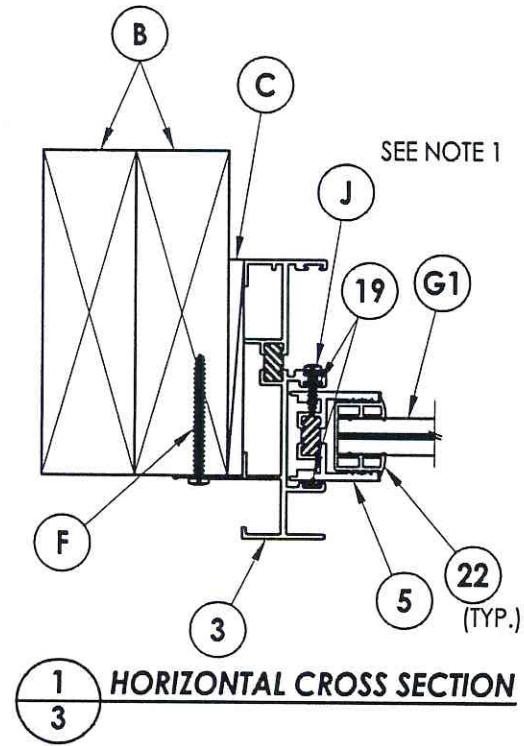


NOTE:

1. Item #J located six inches from each end then 12" o.c.

PRODUCT:	FLEETWOOD GLACIER 3300 (0XX0)	
PART OR ASSEMBLY:	HORIZONTAL CROSS SECTIONS	
BY		
REVISIONS		
NO.	DATE	
<b>RW</b> BUILDING CONSULTANTS, INC. 813.659.9197		
DATE:	1/21/14	
SCALE:	N.T.S.	
DWG. BY:	JK	
CHK. BY:	LFS	
DRAWING NO.:	L-7113	
SHEET	3	OF 9

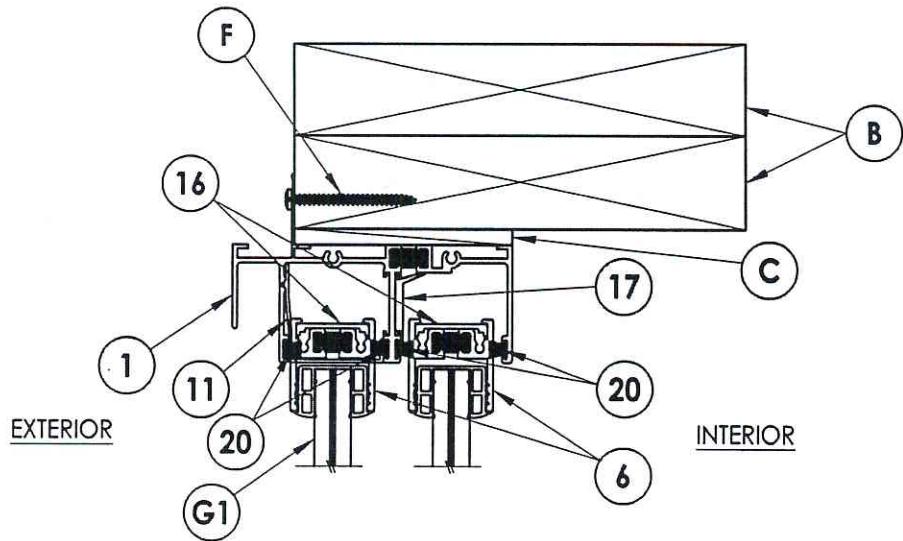

1  
4 VERTICAL CROSS SECTION

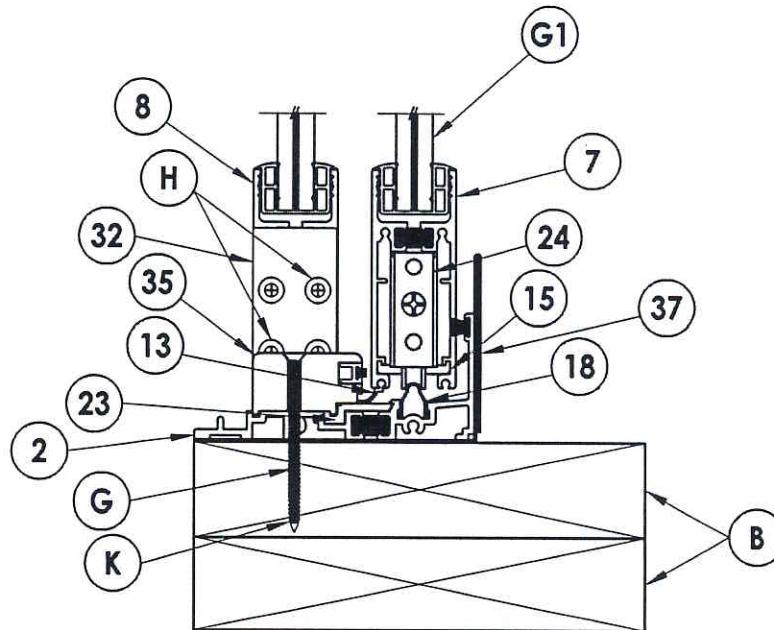


2  
4 VERTICAL CROSS SECTION

Testing Evaluation Laboratories Inc  
Specimen Complies with Drawing  
Deviations Noted TEL # 01991034  
Date 3/21/14 Verified by *JK*


PRODUCT:	FLEETWOOD GLACIER 3300 (oxxo)		
PART OR ASSEMBLY:	VERTICAL CROSS SECTIONS		
BY			
REVISIONS			
NO. DATE			
DATE: 1/21/14			
SCALE: N.T.S.			
DWG. BY: JK			
CHK. BY: LFS			
DRAWING NO.:	L-7113		
SHEET 4 OF 9			




DATE: 1/21/14  
SCALE: N.T.S.  
DWG. BY: JK  
CHK. BY: LFS  
DRAWING NO.:  
L-7113  
SHEET 4 OF 9

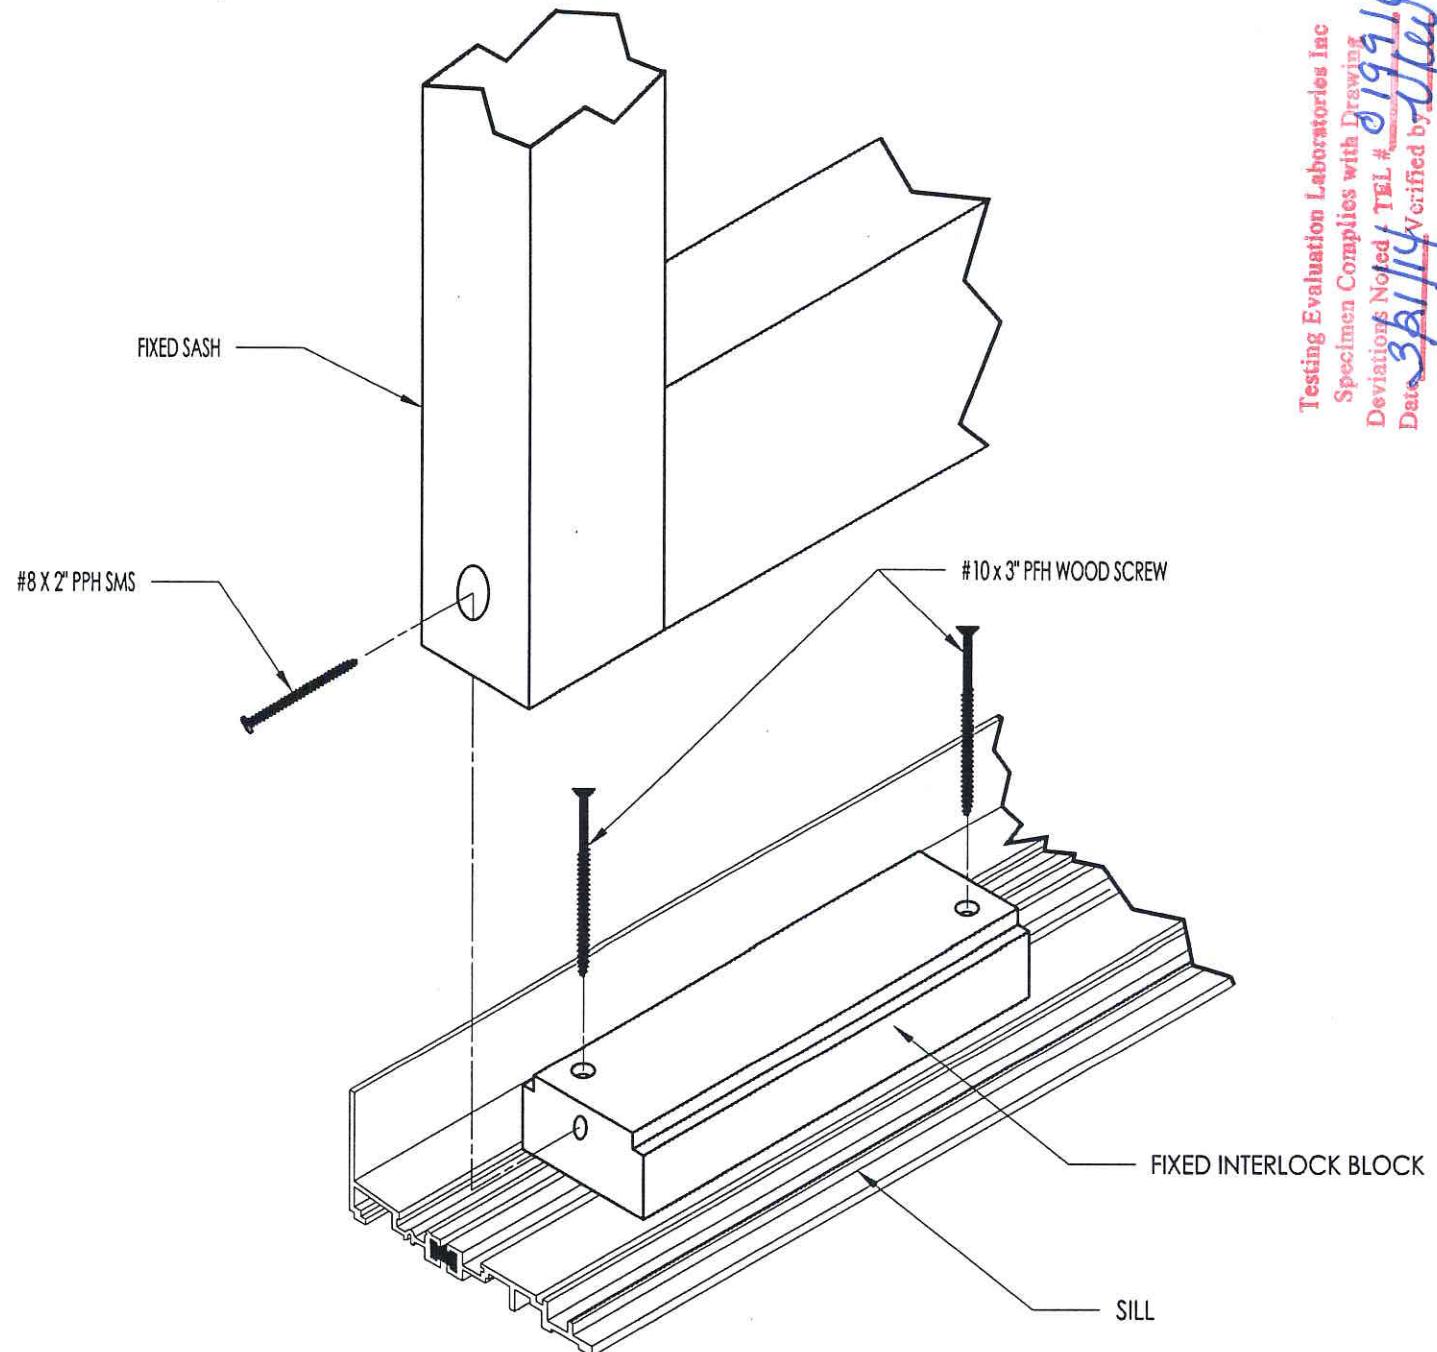


Testing Evaluation Laboratories Inc  
Specimen Complies with Drawing  
Deviations Noted TEL # 01991  
Date 3/1/14 Verified by Stacy

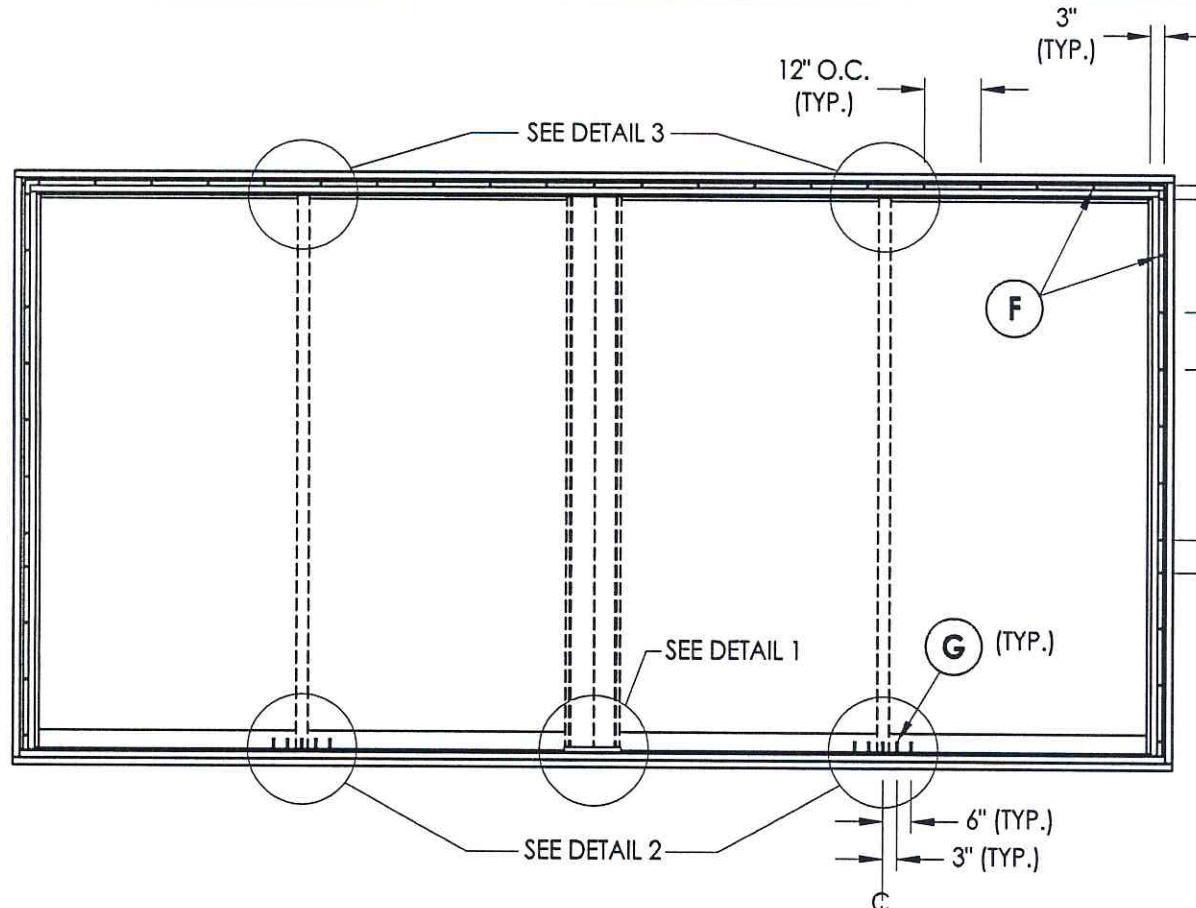


**FRAME ANCHORING**  
2X buck construction

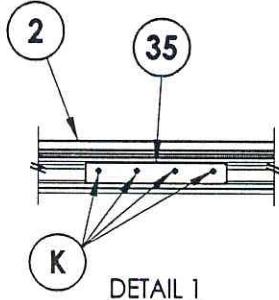

DETAIL 1

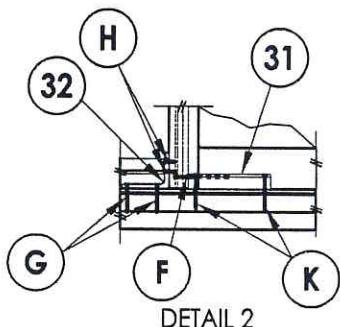


DETAIL 2

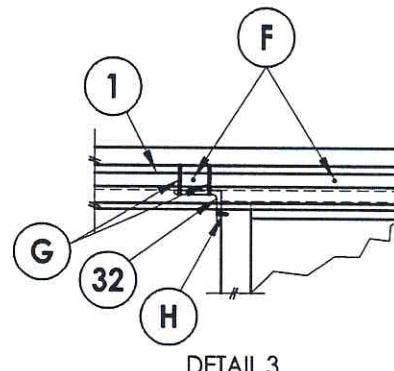


DETAIL 3

Testing Evaluation Laboratories Inc  
Specimen Complies with Drawing  
Deviations Noted / TEL # 019104 ✓  
Date 3/10/14 Verified by JK


PRODUCT:	FLEETWOOD GLACIER 3300 (OXO)		
PART OR ASSEMBLY:	FRAME ANCHORING		
BY			
REVISIONS			
NO. DATE			
DATE: 1/21/14			
SCALE: N.T.S.			
DWG. BY: JK			
CHK. BY: LFS			
DRAWING NO.:			
L-7113			
SHEET <u>6</u> OF <u>9</u>			

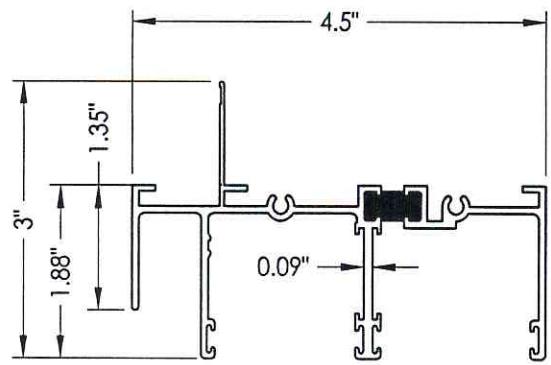

1 HEAD W/ NIAL FIN

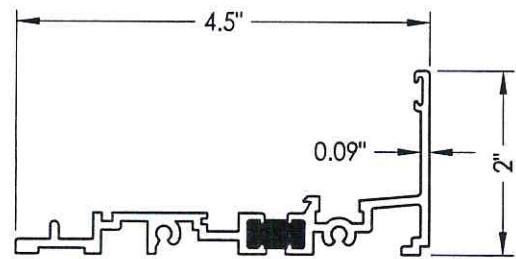


2 SILL

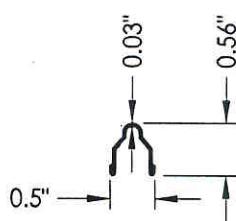


18 TRACK




11 HEAD CHANNEL FILLER

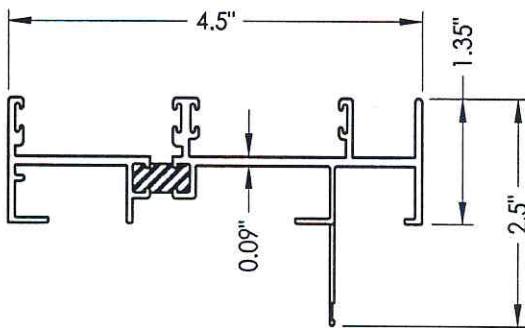


3 JAMB W/ NIAL FIN

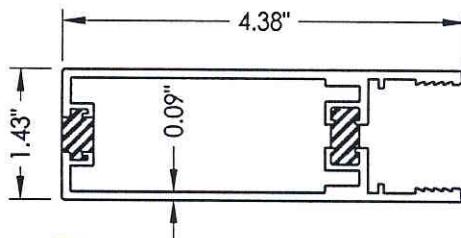


4 LOCK STILE

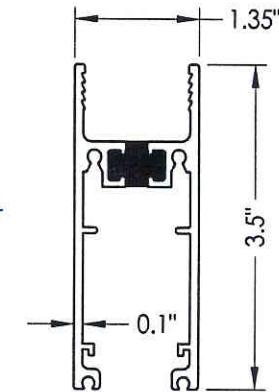


7 SLIDING BOTTOM RAIL

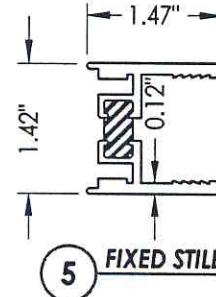

5 FIXED STILE

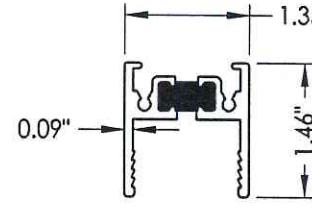


6 TOP RAIL

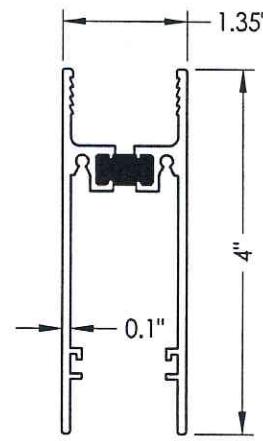

8 FIXED BOTTOM RAIL

Testing Evaluation Laboratories Inc  
Specimen Complies with Drawing  
Deviations Noted TEL # 0199-1014  
Date 3/21/14 Verified by JLH

PRODUCT:	FLEETWOOD GLACIER 3300 (0XX0)		
PART OR ASSEMBLY:	COMPONENTS		
BY			
REVISIONS			
NO. DATE			
DATE: 2/24/14			
SCALE: N.T.S.			
DWG. BY: JK			
CHK. BY: LFS			
DRAWING NO.: L-7113			
SHEET 7 OF 9			

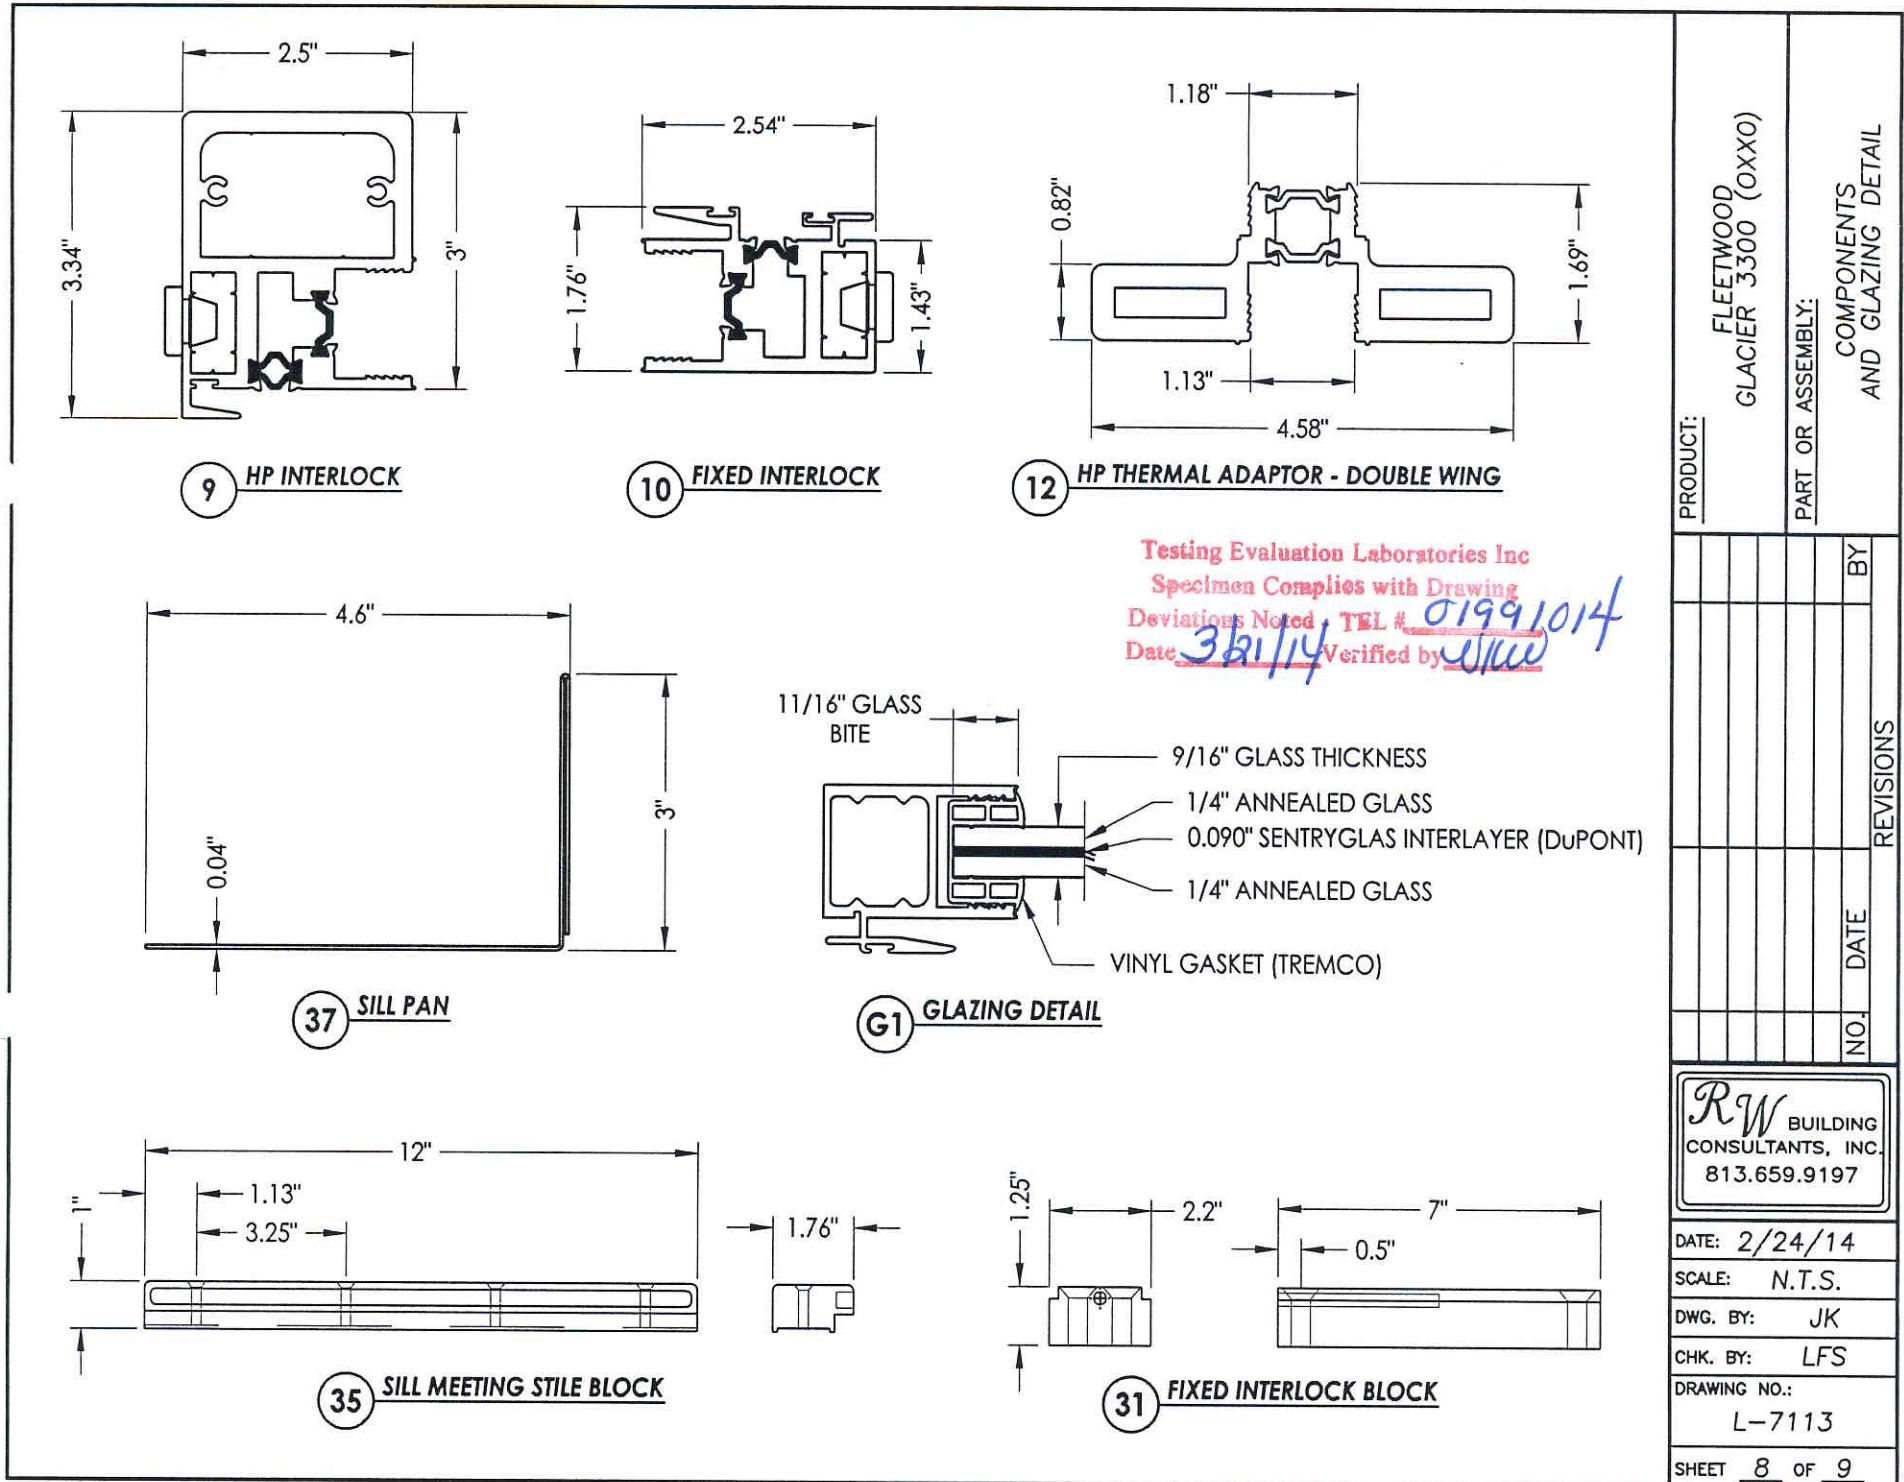

## **BILL OF MATERIALS**

BILL OF MATERIALS		
ITEM #	DESCRIPTION	MATERIAL
B	2X BUCK SG >= 0.42	WOOD
C	1/4" MAX. SHIM SPACE	-
F	#10 X 2" PPH SMS	STEEL
G	#10 X 2-1/2" PPH SMS	STEEL
H	#10 X 1" PFH SMS	STEEL
J	#8 X 3/4" PPH SELF-DRILLING SMS	STEEL
K	#10 X 3" PFH WS	STEEL
L	1/4-20 X 1 1/2" MACHINE SCREW	STEEL
1	HEAD W/ NAIL FIN	6063-T6 ALUM
2	SILL	6063-T6 ALUM
3	JAMB W/ NAIL FIN	6063-T6 ALUM
4	LOCK STILE	6063-T6 ALUM
5	FIXED STILE	6063-T6 ALUM
6	TOP RAIL	6063-T6 ALUM
7	SLIDING BOTTOM RAIL	6063-T6 ALUM
8	FIXED BOTTOM RAIL	6063-T6 ALUM
9	HP INTERLOCK	6063-T6 ALUM
10	FIXED INTERLOCK	6063-T6 ALUM
11	HEAD CLOSER	6063-T6 ALUM
12	HP THERMAL ADAPTOR - DOUBLE WING	6063-T6 ALUM
13	SLIDING BOTTOM RAIL WEATHERSTRIP	-
14	LOCK STILE SPREADER	6063-T6 ALUM
15	BOTTOM RAIL SPREADER	6063-T6 ALUM
16	TOP RAIL ISOLATOR	6063-T6 ALUM
17	ISOLATOR	6063-T6 ALUM
18	S.S. TRACK	SS
19	2 FINGER VINYL	-
20	SMALL FINSEAL	-
21	LARGE FINSEAL	-
22	GLAZING VINYL 1" SCR-900, 80 DUROMETER	-
23	SILL ISOLATOR	6063-T6 ALUM
24	ROLLER ASSEMBLY	6063-T6 ALUM
25	STRIKE PLATE ASSY.(JAMB)	6063-T6 ALUM
26	LATCH ASSY.(JAMB)	6063-T6 ALUM
31	FIXED INTERLOCK BLOCK	6063-T6 ALUM
32	3" X 4" L-BRACKET	6063-T6 ALUM
35	SILL MEETING STILE BLOCK	6063-T6 ALUM
37	SILL PAN	-

Testing Evaluation Laboratories Inc  
Specimen Complies with Drawing  
Deviations Noted - TEL # 01991914  
Date 3/1/14 Certified by JLW

<u>PRODUCT:</u>		FLEETWOOD GLACIER 3300 (OXXO)	
<u>PART OR ASSEMBLY:</u>		BILL OF MATERIALS	
NO.	DATE	BY	REVISIONS
 <p><b>RW</b> BUILDING CONSULTANTS, INC. 813.659.9197</p>			
DATE: 2/24/14			
SCALE: N.T.S.			
DWG. BY: JK			
CHK. BY: LFS			
DRAWING NO.:			
L-7113			
SHEET <u>9</u> OF <u>9</u>			



DATE: 2/24/14

SCALE: N.T.S.

DWG. BY: JK

CHK. BY: LFS

DRAWING NO.:

L-7113

## TABLE OF CONTENTS

TABLE OF CONTENTS	
SHEET #	DESCRIPTION
1	Table of contents
2	Test elevation
3	Horizontal cross sections
4	Vertical cross sections
5	Sill meeting stile block details
6	Frame anchoring
7	Components
8	Components and glazing detail
9	Bill of materials

Testing Evaluation Laboratories Inc  
Specimen Complies with Drawing  
Deviations Noticed: TEL # 01991914  
Date 3/1/14 Verified by blue



DATE: 2/24/14

SCALE: N.T.S.


DWG. BY: JK

CHK. BY: LFS

DRAWING NO.

L-7114

SHEET 1 OF 9

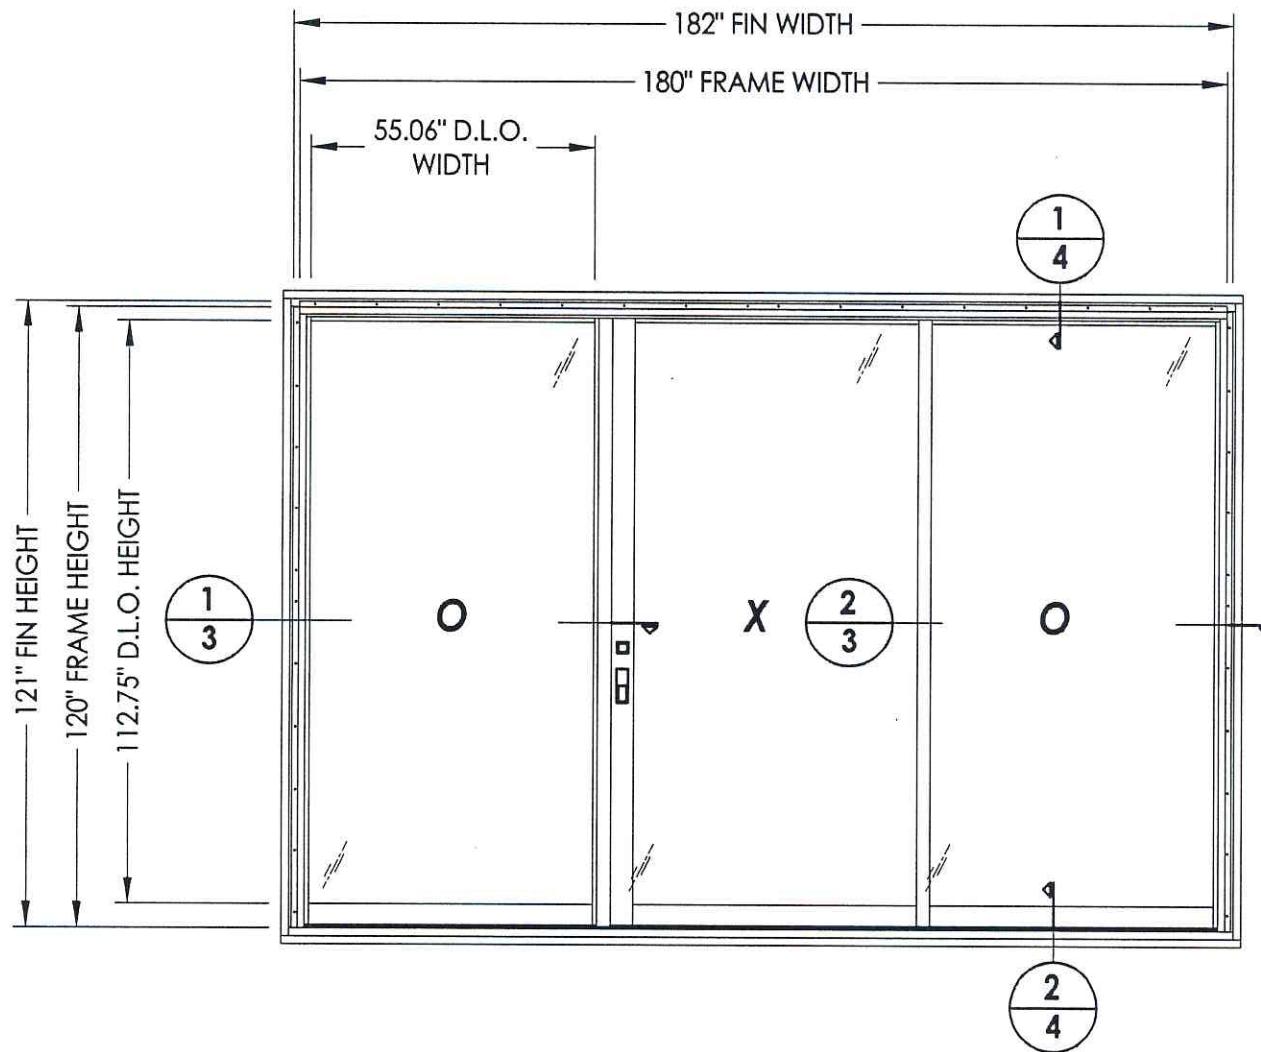

Testing Evaluation Laboratories Inc  
Specimen Complies with Drawing  
Deviations Noted / TEL # 01991014  
Date 3/10/14 Verified by dlw

PRODUCT:	FLEETWOOD GLACIER 3300 (OXO)	
PART OR ASSEMBLY:	TEST ELEVATION	
NO.	DATE	BY
		REVISIONS
 <b>RW</b> BUILDING CONSULTANTS, INC. 813.659.9197		
DATE: 2/24/14		
SCALE: N.T.S.		
DWG. BY: JK		
CHK. BY: LFS		
DRAWING NO.:		
L-7114		
SHEET	2	OF 9

DATE: 2/24/14

SCALE: N.T.S.


DWG. BY: JK


CHK. BY: *LFS*

DRAWING NO.:


L-7114

SHEET 2 OF 9

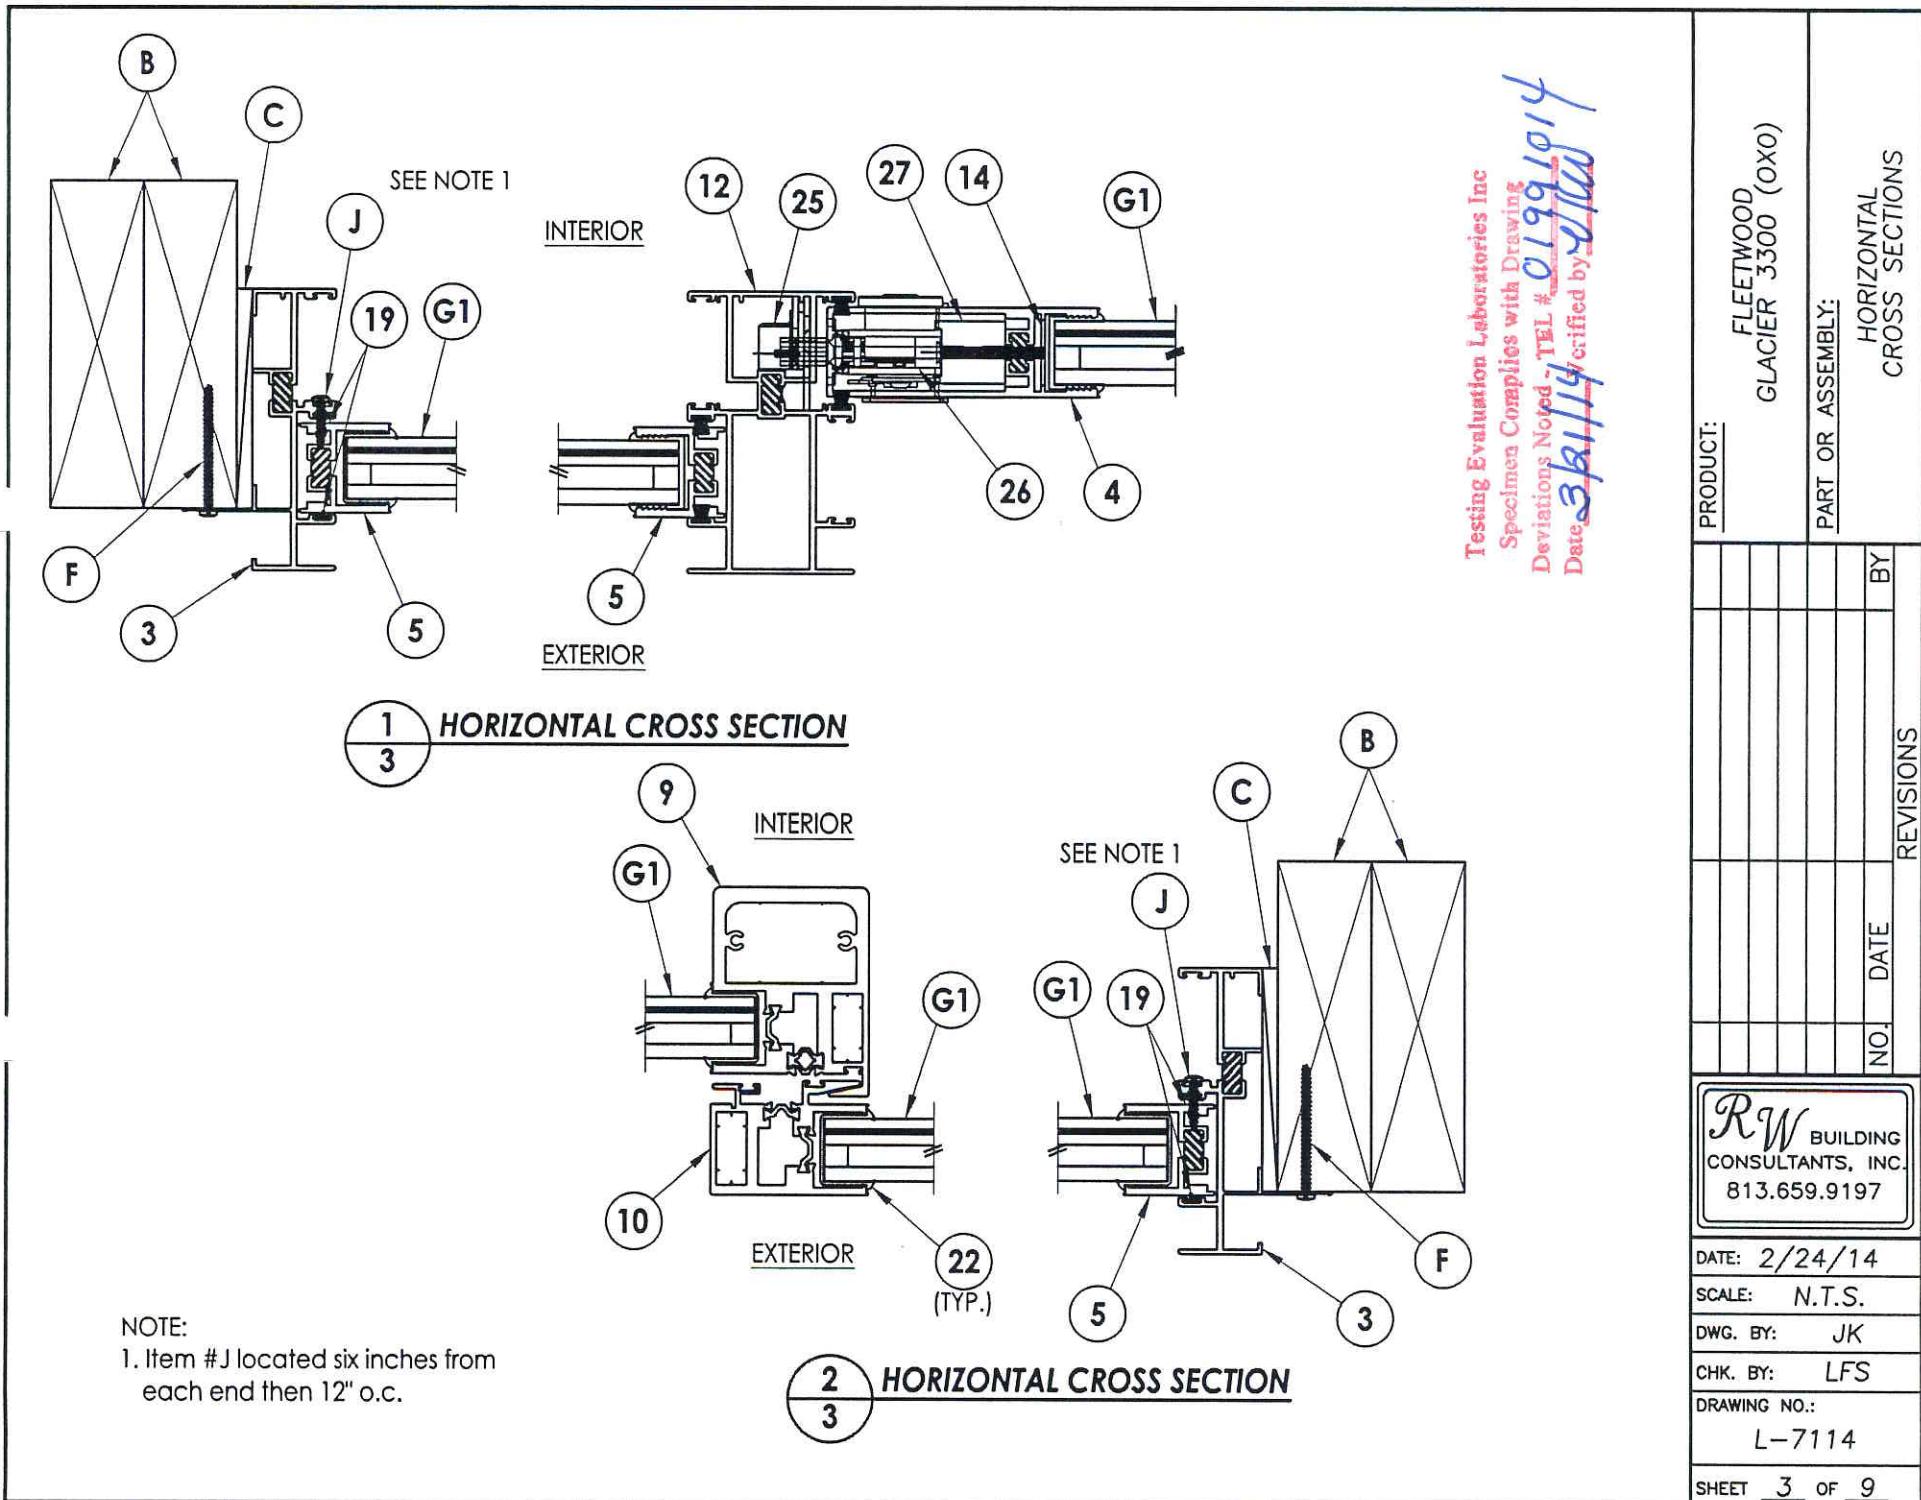

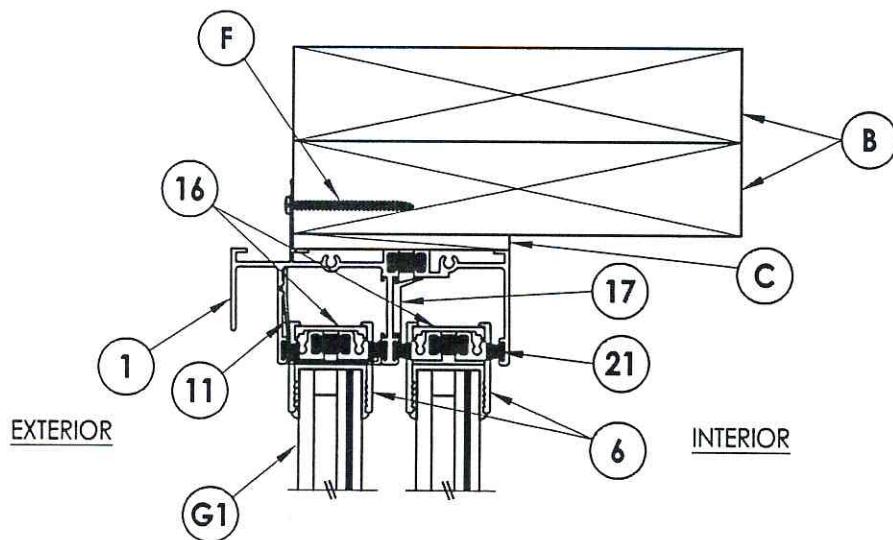


1 VERTICAL CROSS SECTION  
4

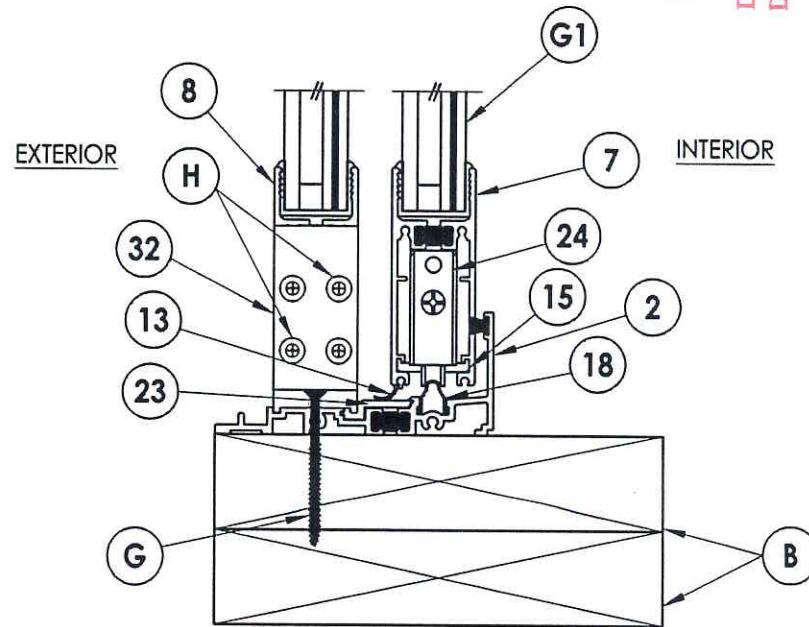

**2** VERTICAL CROSS SECTION

Testing Evaluation Laboratories Inc  
Specimen Complies with Drawing  
Deviation Note TEL # 01991014  
Date 3/21/14 Verified by Jay

© 2014 R.W. BUILDING CONSULTANTS INC.





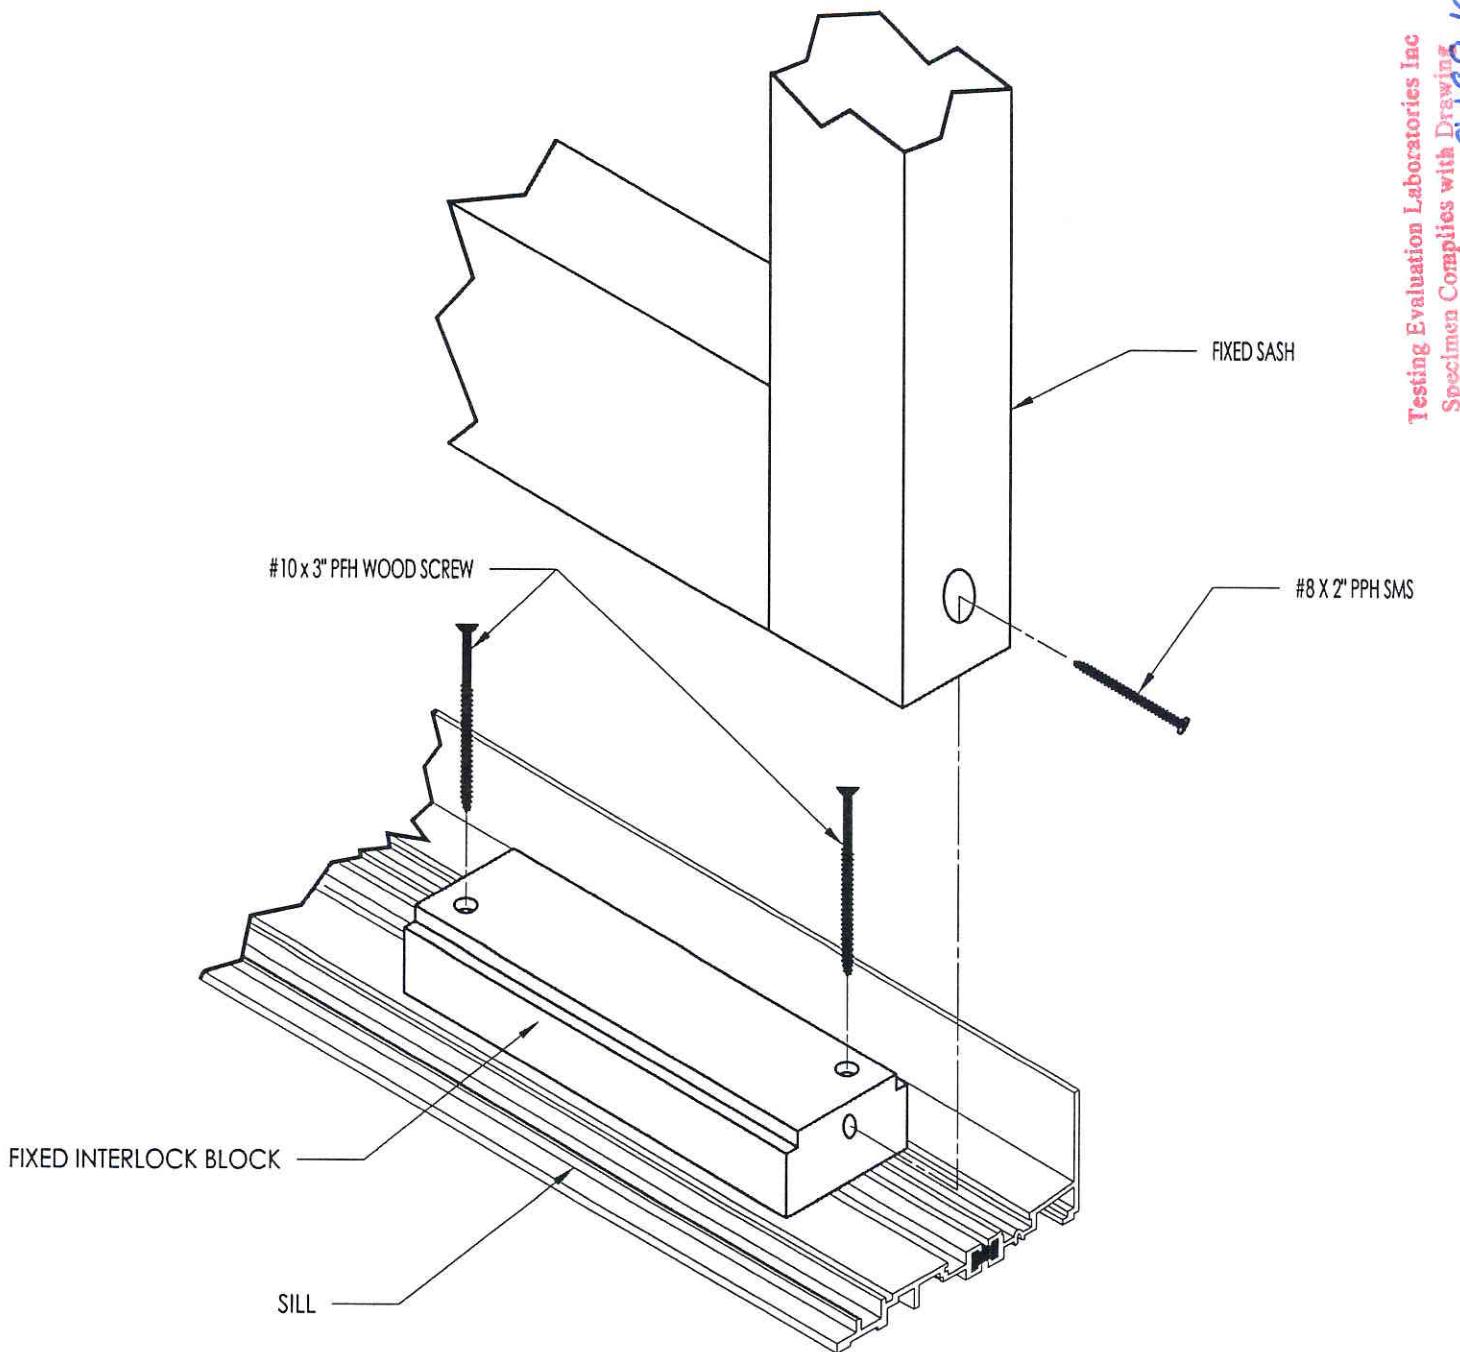


Testing Evaluation Laboratories Inc  
Specimen Complies with Drawing  
Deviations Noted - TEL # 01991014  
Date: 3/1/14 Verified by JK

PRODUCT:		FLEETWOOD GLACIER 3300 (OXO)	
PART OR ASSEMBLY:		SILL MEETING STILE BLOCK DETAILS	
NO.	DATE	BY	REVISIONS


  

<i>RW</i> BUILDING CONSULTANTS, INC. 813.659.9197
DATE: 2/24/14
SCALE: N.T.S.
DWG. BY: JK
CHK. BY: LFS
DRAWING NO.: L-7114
SHEET 5 OF 9

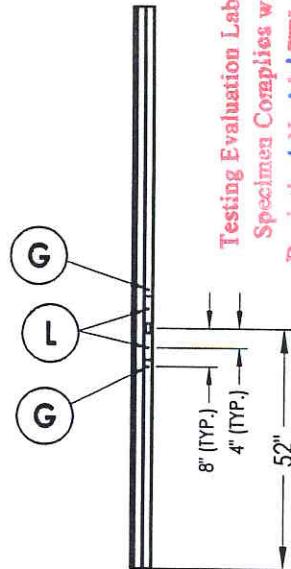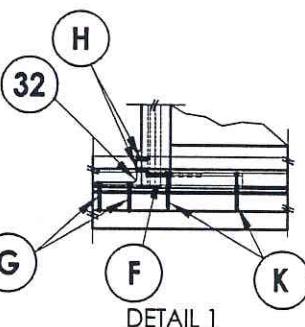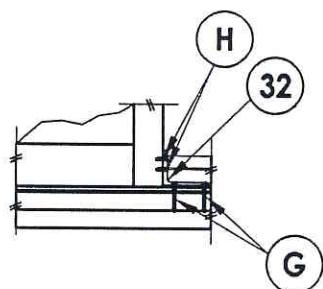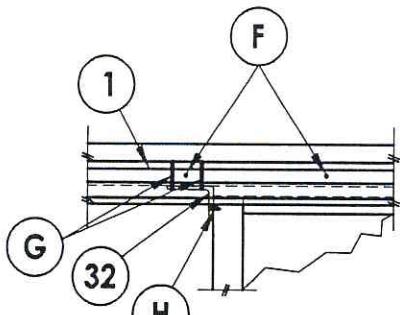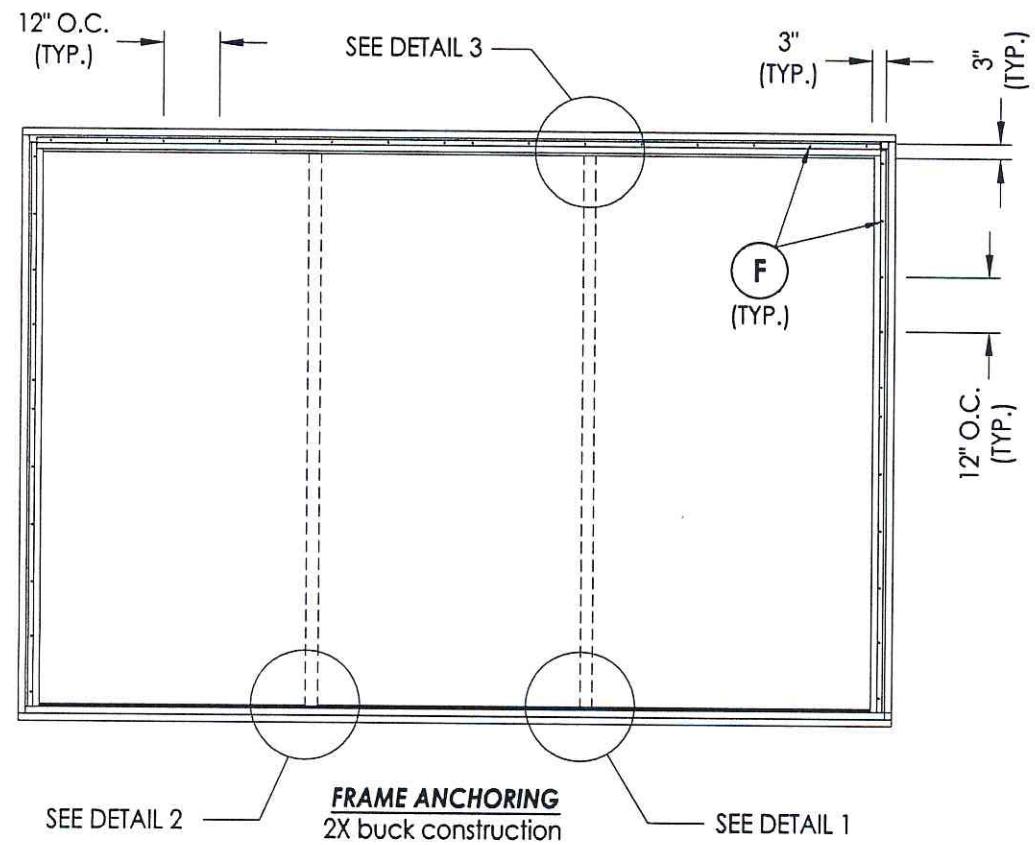


Testing Evaluation Laboratories Inc  
Specimen Complies with Drawing  
Deviation: ~~None~~ TEL # ~~01991914~~  
Date ~~3/21/14~~ Verified by ~~JK~~

PRODUCT:	FLEETWOOD GLACIER 3300 (OXO)	
PART OR ASSEMBLY:	FRAME ANCHORING	
REVISIONS		
NO.	DATE	BY
<p>RW BUILDING CONSULTANTS, INC. 813.659.9197</p>		
DATE: 2/24/14		
SCALE: N.T.S.		
DWG. BY: JK		
CHK. BY: LFS		
DRAWING NO.: L-7114		
SHEET <u>6</u> OF <u>9</u>		

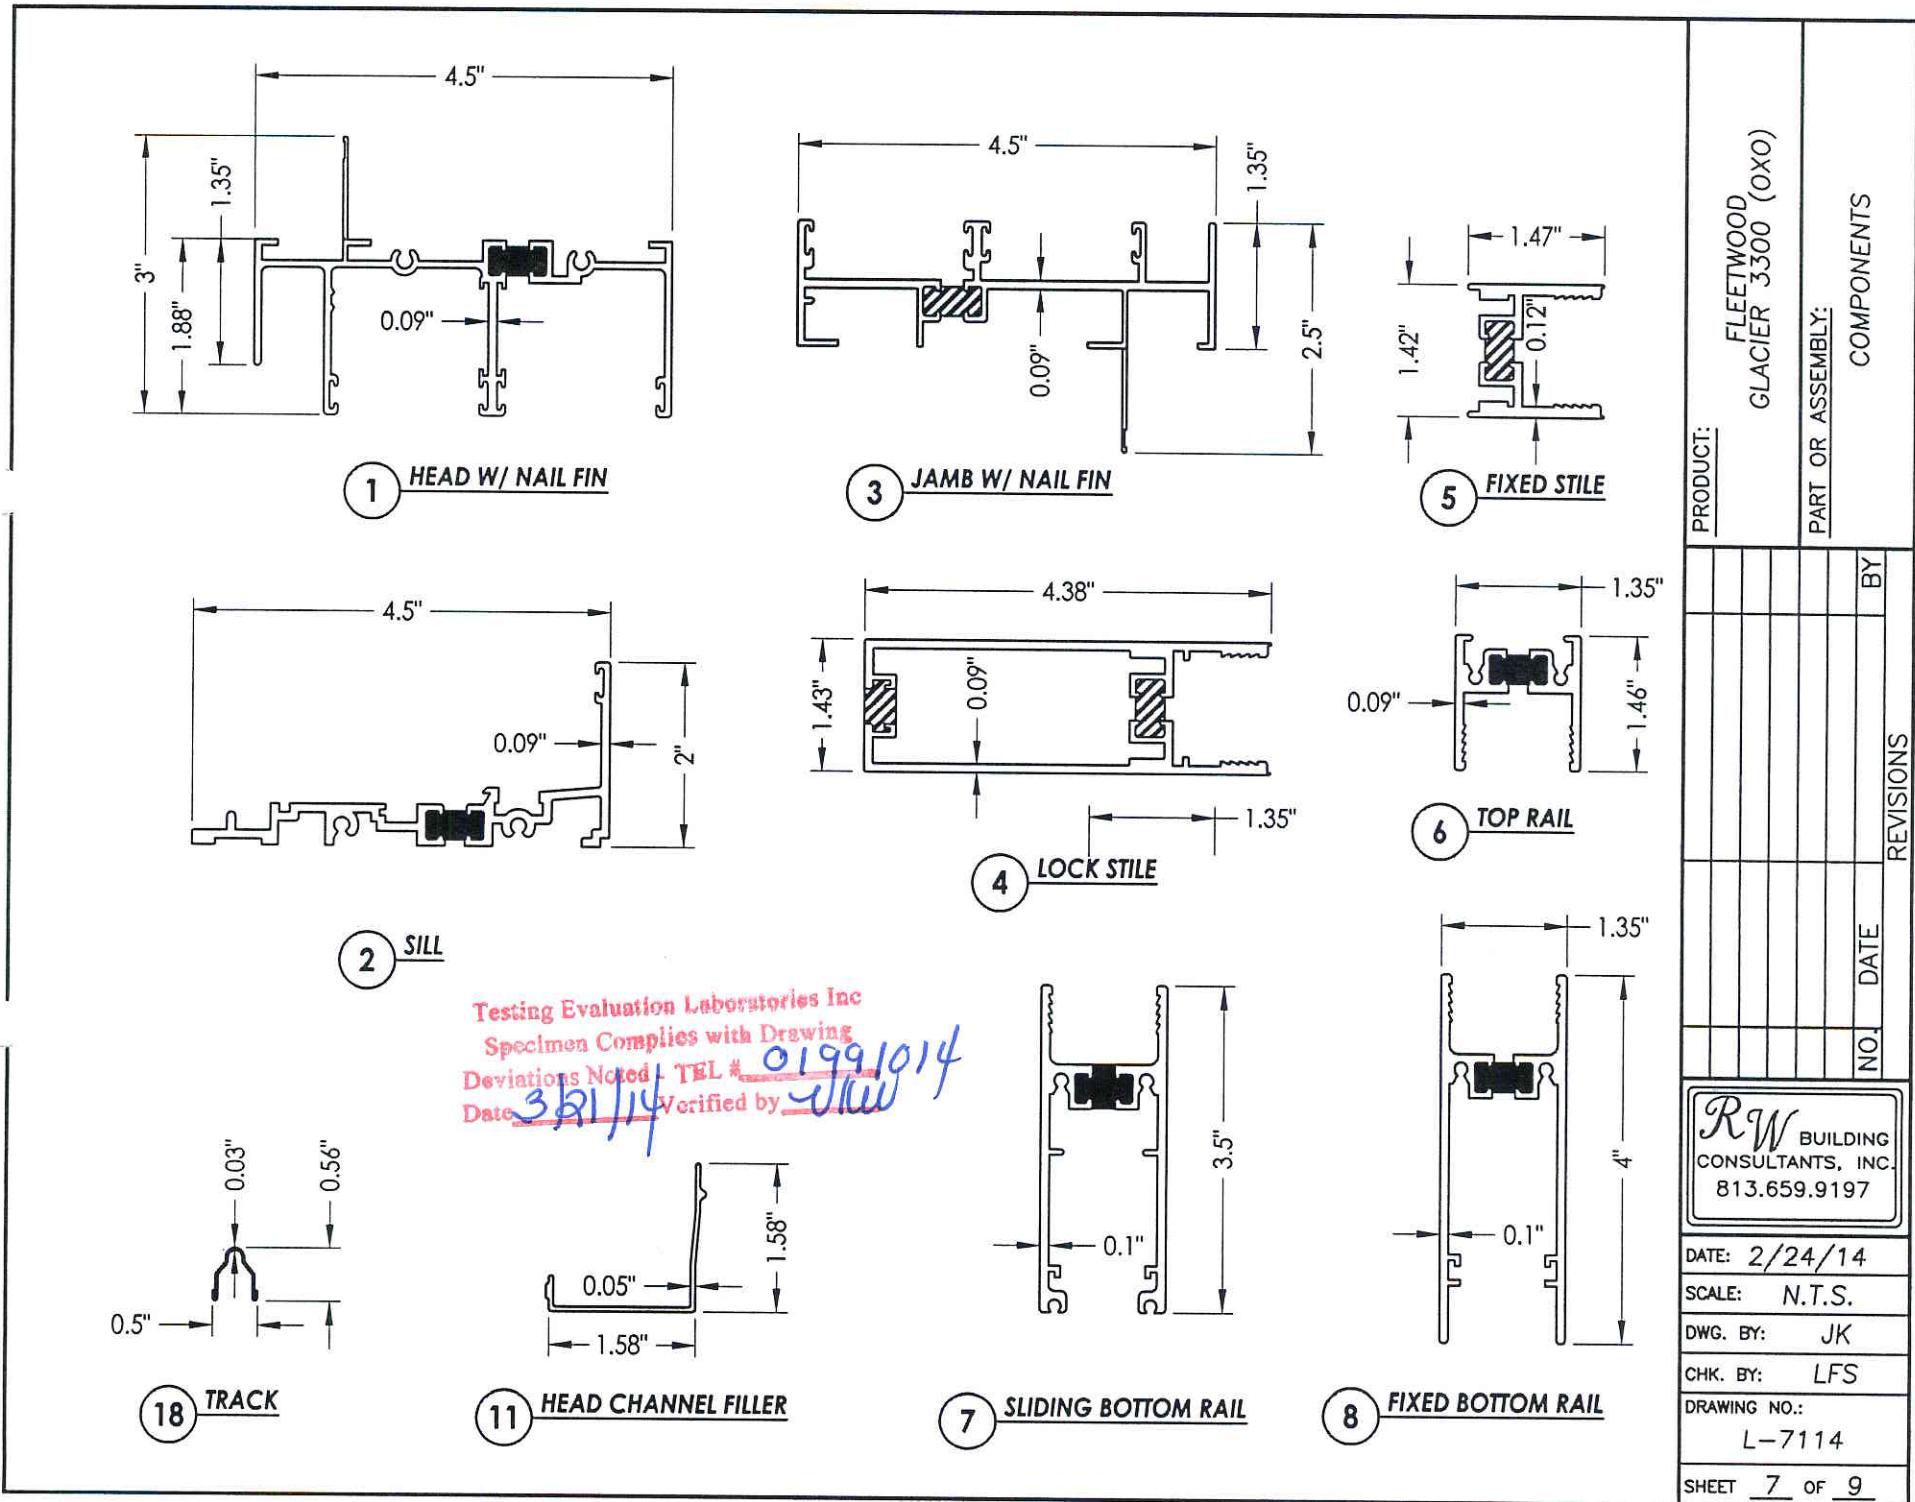


Testing Evaluation Laboratories Inc  
Specimen Complies with Drawing


Deviations Noted - TEL # 0199/014  
Date 3/8/14 Verified by JKW

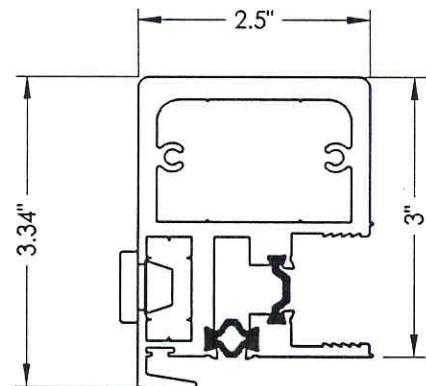


**9** HP INTERLOCK

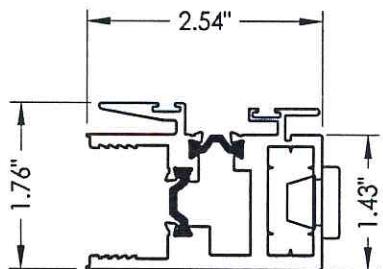


**10** FIXED INTERLOCK

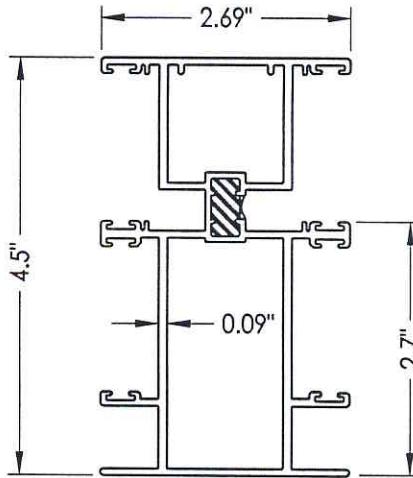

12 FALL JAMB

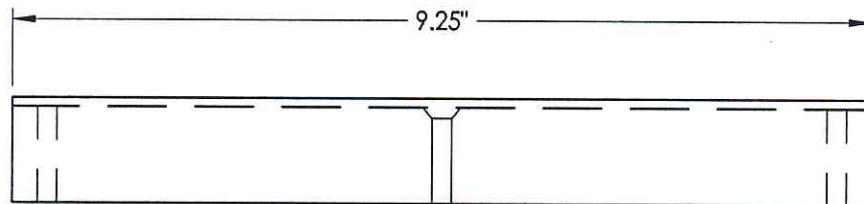

**27 SPACER**  
Archetype Narrow Latch

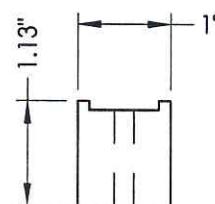

The diagram illustrates the cross-section of a laminated glass panel. It consists of the following layers from left to right:

- 11/16" GLASS BITE
- ALUMINUM SPACER
- 3/16" ANNEALED GLASS
- 0.090" DUPONT SENTRYGLAS INTERLAYER
- 3/16" ANNEALED GLASS
- AIR SPACE
- 1/4" TEMPERED GLASS
- VINYL GASKET (TREMCO)

Annotations on the left side point to the "11/16" GLASS BITE" and the "ALUMINUM SPACER". Annotations on the right side point to the "1" GLASS THICKNESS" and the "VINYL GASKET (TREMCO)".

**G1** GLAZING DETAIL

Testing Evaluation Laboratories Inc  
Specimen Complies with Drawing  
Deviations Noted TEL # 8199  
Date 3/11/14 Verified by JW



DATE: 2/24/14

SCALE: N.T.S.

DWG. BY: JK

CHK. BY: LFS

DRAWING NO.:

L-7114

SHEET 8 OF 9

### BILL OF MATERIALS

ITEM #	DESCRIPTION	MATERIAL
B	2X BUCK SG >= 0.42	WOOD
C	1/4" MAX. SHIM SPACE	-
F	#10 X 2" PPH SMS	STEEL
G	#10 X 2-1/2" PPH SMS	STEEL
H	#10 X 1" PFH SMS	STEEL
J	#8 X 3/4" PPH SELF-DRILLING SMS	STEEL
K	#10 X 3" PFH WS	STEEL
L	1/4-20 - 1/2" MACHINE SCREW	STEEL
1	HEAD W/ NAIL FIN	6063-T6 ALUM
2	SILL	6063-T6 ALUM
3	JAMB W/ NAIL FIN	6063-T6 ALUM
4	LOCK STILE	6063-T6 ALUM
5	FIXED STILE	6063-T6 ALUM
6	TOP RAIL	6063-T6 ALUM
7	SLIDING BOTTOM RAIL	6063-T6 ALUM
8	FIXED BOTTOM RAIL	6063-T6 ALUM
9	HP INTERLOCK	6063-T6 ALUM
10	FIXED INTERLOCK	6063-T6 ALUM
11	HEAD CLOSER	6063-T6 ALUM
12	FALL JAMB	6063-T6 ALUM
13	SLIDING BOTTOM RAIL WEATHER STRIP	-
14	LOCK STILE SPREADER	6063-T6 ALUM
15	BOTTOM RAIL SPREADER	6063-T6 ALUM
16	TOP RAIL ISOLATOR	6063-T6 ALUM
17	ISOLATOR	6063-T6 ALUM
18	S.S. TRACK	SS
19	2 FINGER VINYL	-
20	SMALL FINSEAL	-
21	LARGE FINSEAL	-
22	GLAZING VINYL 1" SCR-900, 80 DUROMETER	-
23	SILL ISOLATOR	6063-T6 ALUM
24	ROLLER ASSEMBLY	-
25	STRIKE PLATE ASSY.(JAMB)	-
26	LATCH ASSY.(JAMB)(Archetype Narrow Latch)	-
27	SPACER (ARCHETYPE NARROW LATCH)	-
32	3" X 4" L-BRACKETT	6063-T6 ALUM

Testing Evaluation Laboratories Inc

Specimen Complies with Drawing

Deviations Noted TEL # 019910814

Date 3/8/14 Verified by JK

PRODUCT:	FLEETWOOD GLACIER 3300 (OXO)	
PART OR ASSEMBLY:	BILL OF MATERIALS	
NO. DATE	REVISIONS	BY
 <b>RW</b> BUILDING CONSULTANTS, INC. 813.659.9197		
DATE: 2/24/14		
SCALE: N.T.S.		
DWG. BY: JK		
CHK. BY: LFS		
DRAWING NO.: L-7114		
SHEET 9 OF 9		

## TABLE OF CONTENTS

TABLE OF CONTENTS	
SHEET #	DESCRIPTION
1	Table of contents
2	Test elevation
3	Horizontal cross sections
4	Vertical cross sections
5	Sill meeting stile block details
6	Frame anchoring
7	Components
8	Components and glazing detail
9	Bill of materials

Testing Evaluation Laboratories Inc  
Specimen Complies with Drawing  
Deviations Noted TEL # 01991014  
Date 3/21/14 Verified by mlaw



DATE: 2/24/14

SCALE: N.T.S.


DWG. BY: JK

CHK. BY: *LFS*



DRAWING NO.:

L-7112


SHEET 1 OF 9

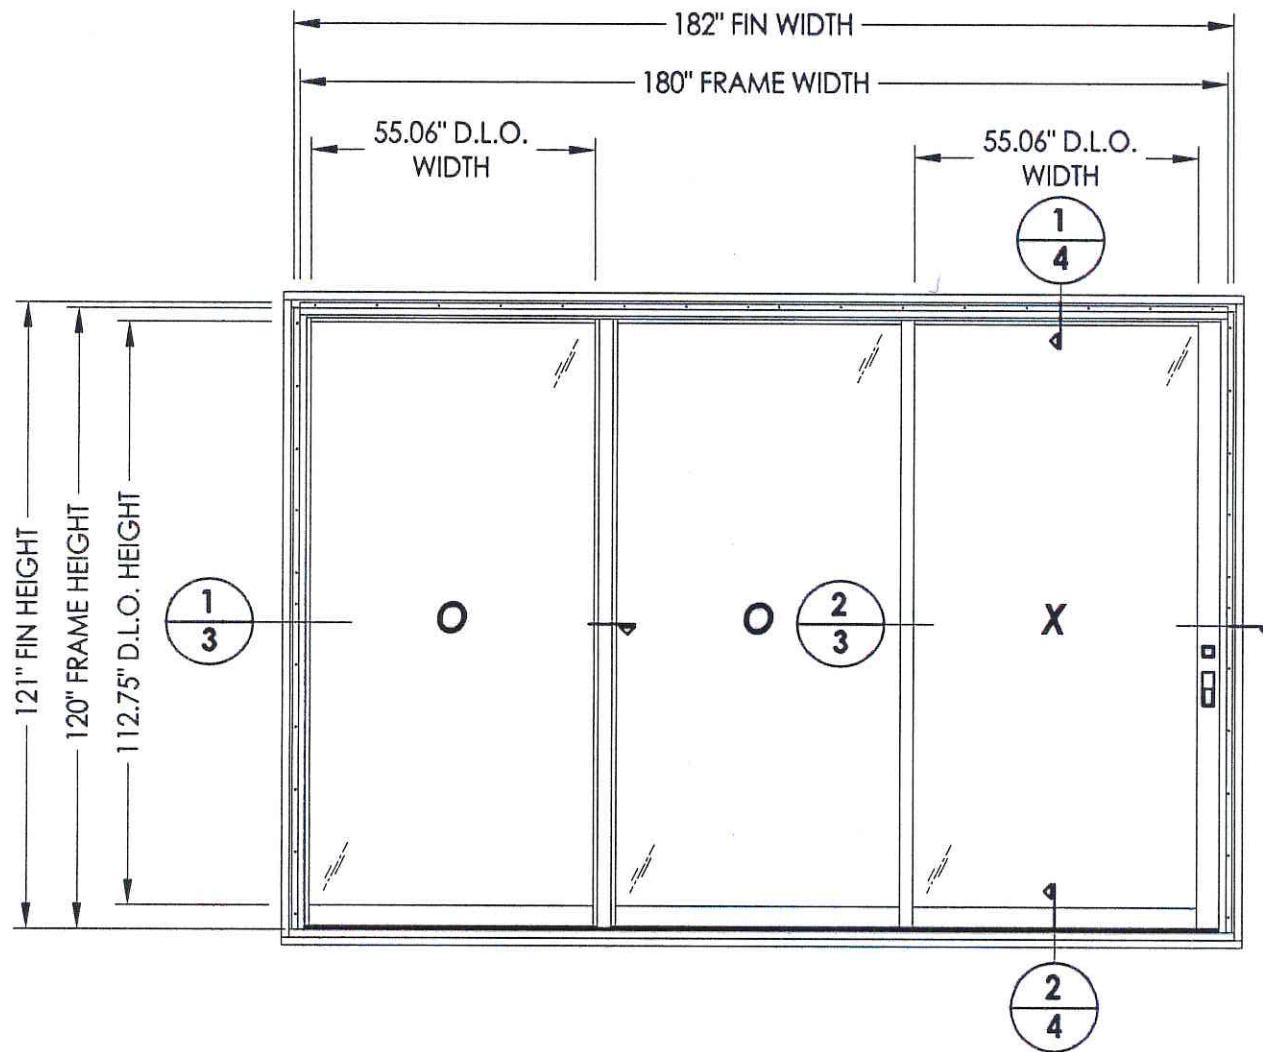

Testing Evaluation Laboratories Inc  
Specimen Complies with Drawing  
Deviations Noted TEL # 019910114  
Date 3/21/14 Verified by JLH

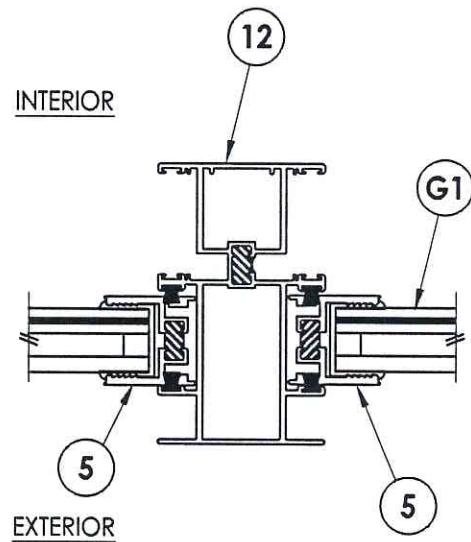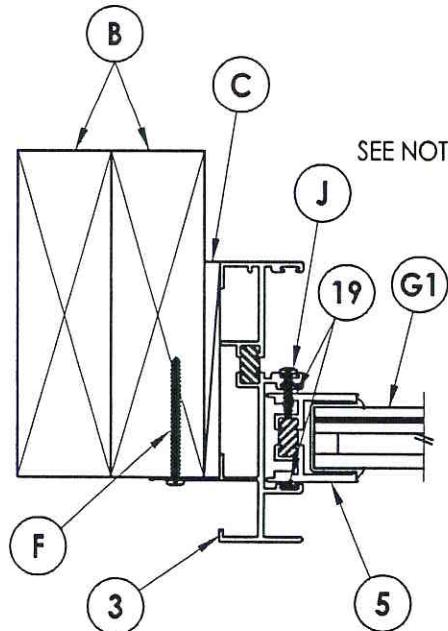

**1/3 HORIZONTAL CROSS SECTION**

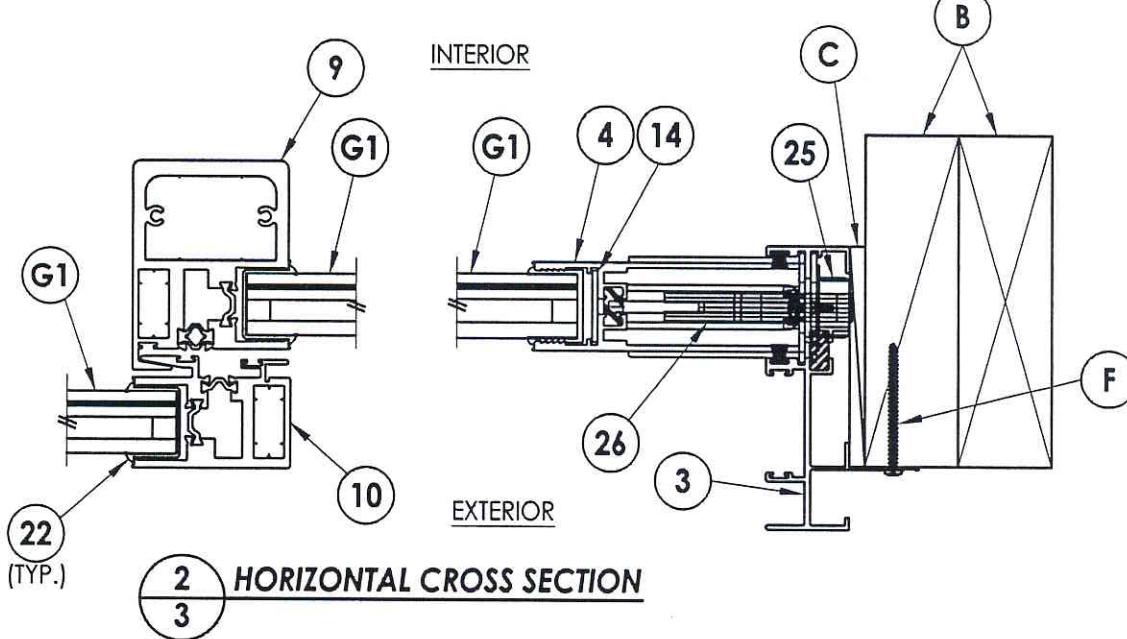


**2/3 HORIZONTAL CROSS SECTION**


NOTE:  
1. Item #J located six inches from  
each end then 12" o.c.

Testing Evaluation Laboratories Inc  
Specimen Complies with Drawing  
Deviations Noted TEL # 01991014  
Date 2/24/14 Verified by JK

PRODUCT:	FLEETWOOD GLACIER 3300 (00X)	
PART OR ASSEMBLY:	HORIZONTAL CROSS SECTIONS	
BY		
REVISIONS		
NO. DATE		
DATE: 2/24/14		
SCALE: N.T.S.		
DWG. BY: JK		
CHK. BY: LFS		
DRAWING NO.:		
L-7112		
SHEET <u>3</u> OF <u>9</u>		

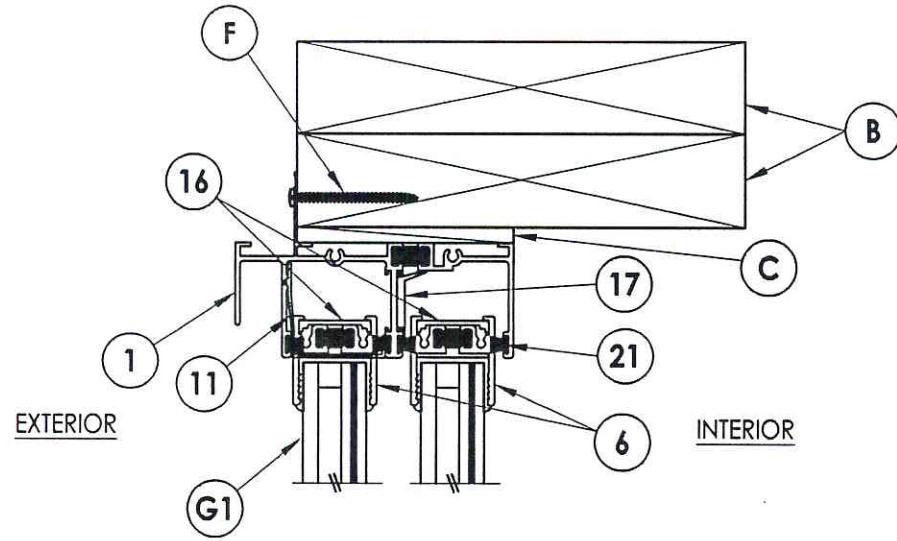


1  
4 VERTICAL CROSS SECTION

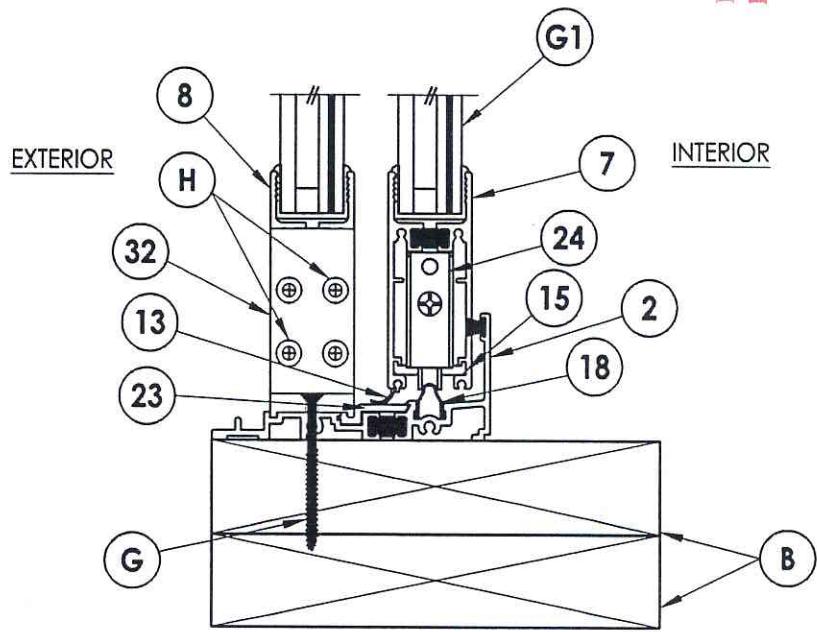

2  
4 VERTICAL CROSS SECTION

Testing Evaluation Laboratories Inc  
Specimen Complies with Drawing  
Deviation Noted TEL # 01991014  
Date 3/11/14 Verified by LFS

PRODUCT:	FLEETWOOD GLACIER 3300 (00X)		
PART OR ASSEMBLY:	VERTICAL CROSS SECTIONS		
BY			
REVISIONS			
NO.	DATE	BY	
 <p>RW BUILDING CONSULTANTS, INC. 813.659.9197</p>			
DATE:	2/24/14		
SCALE:	N.T.S.		
DWG. BY:	JK		
CHK. BY:	LFS		
DRAWING NO.:	L-7112		
SHEET	4	OF	9





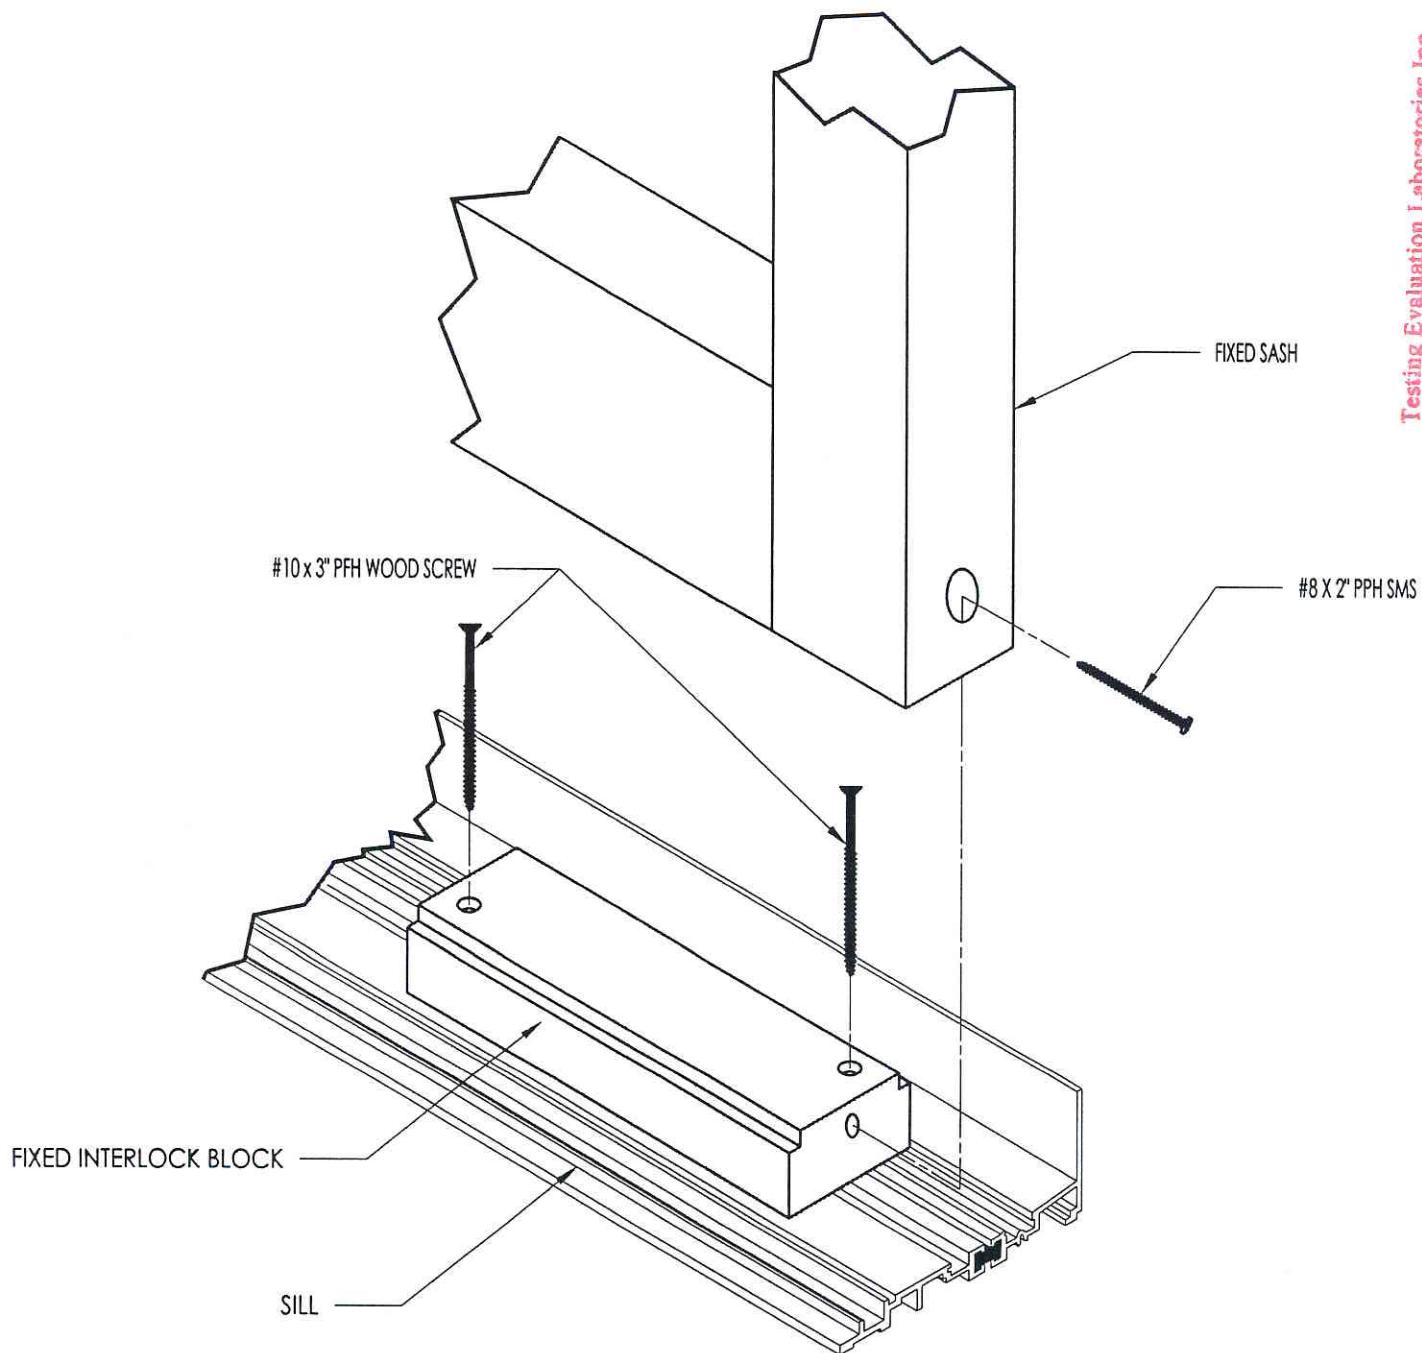


Testing Evaluation Laboratories Inc  
Specimen Complies with Drawing  
Deviations Noted TEL # 01991914  
Date 3/21/14 Verified by JK

PRODUCT:	FLEETWOOD GLACIER 3300 (00X)		
PART OR ASSEMBLY:	SILL MEETING STILE BLOCK DETAILS		
NO.	DATE	BY	REVISIONS


**RW** BUILDING  
CONSULTANTS, INC.  
813.659.9197


DATE: 2/24/14  
SCALE: N.T.S.  
DWG. BY: JK  
CHK. BY: LFS  
DRAWING NO.: L-7112  
SHEET 5 OF 9

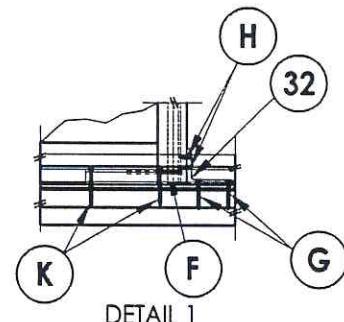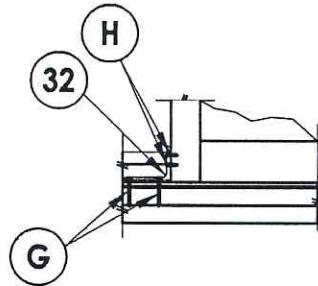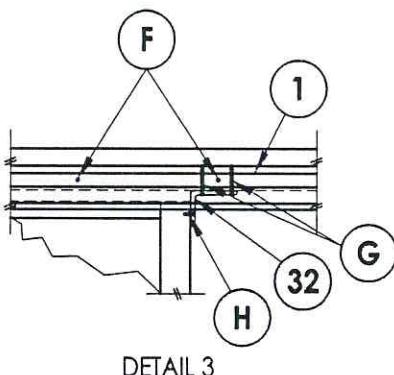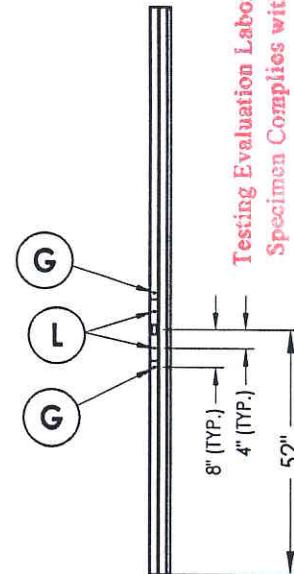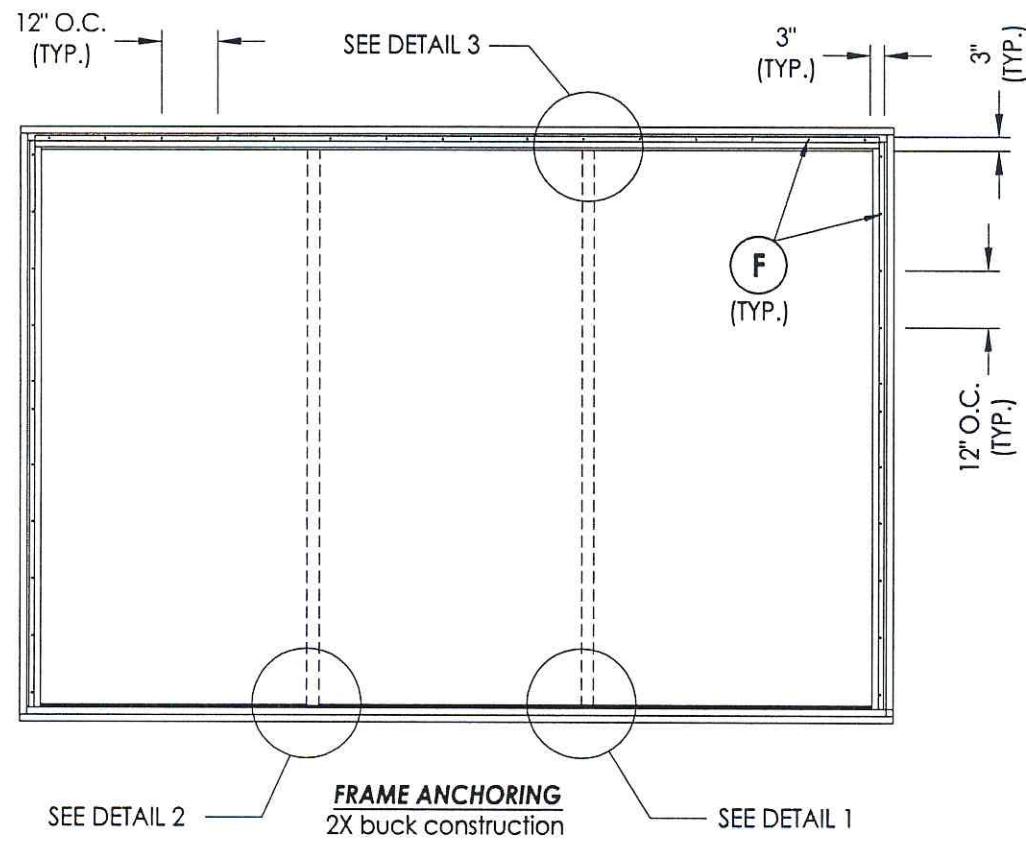


Testing Evaluation Laboratories Inc  
Specimen Complies with Drawing  
Deviations Noted - TEL # 0199104  
Date 3/21/14 Verified by *JLH*

PRODUCT:	FLEETWOOD GLACIER 3300 (00X)	
PART OR ASSEMBLY:	FRAME ANCHORING	
NO. DATE BY		
REVISIONS		
DATE: 2/24/14		
SCALE: N.T.S.		
DWG. BY: JK		
CHK. BY: LFS		
DRAWING NO.: L-7112		
SHEET 6 OF 9		

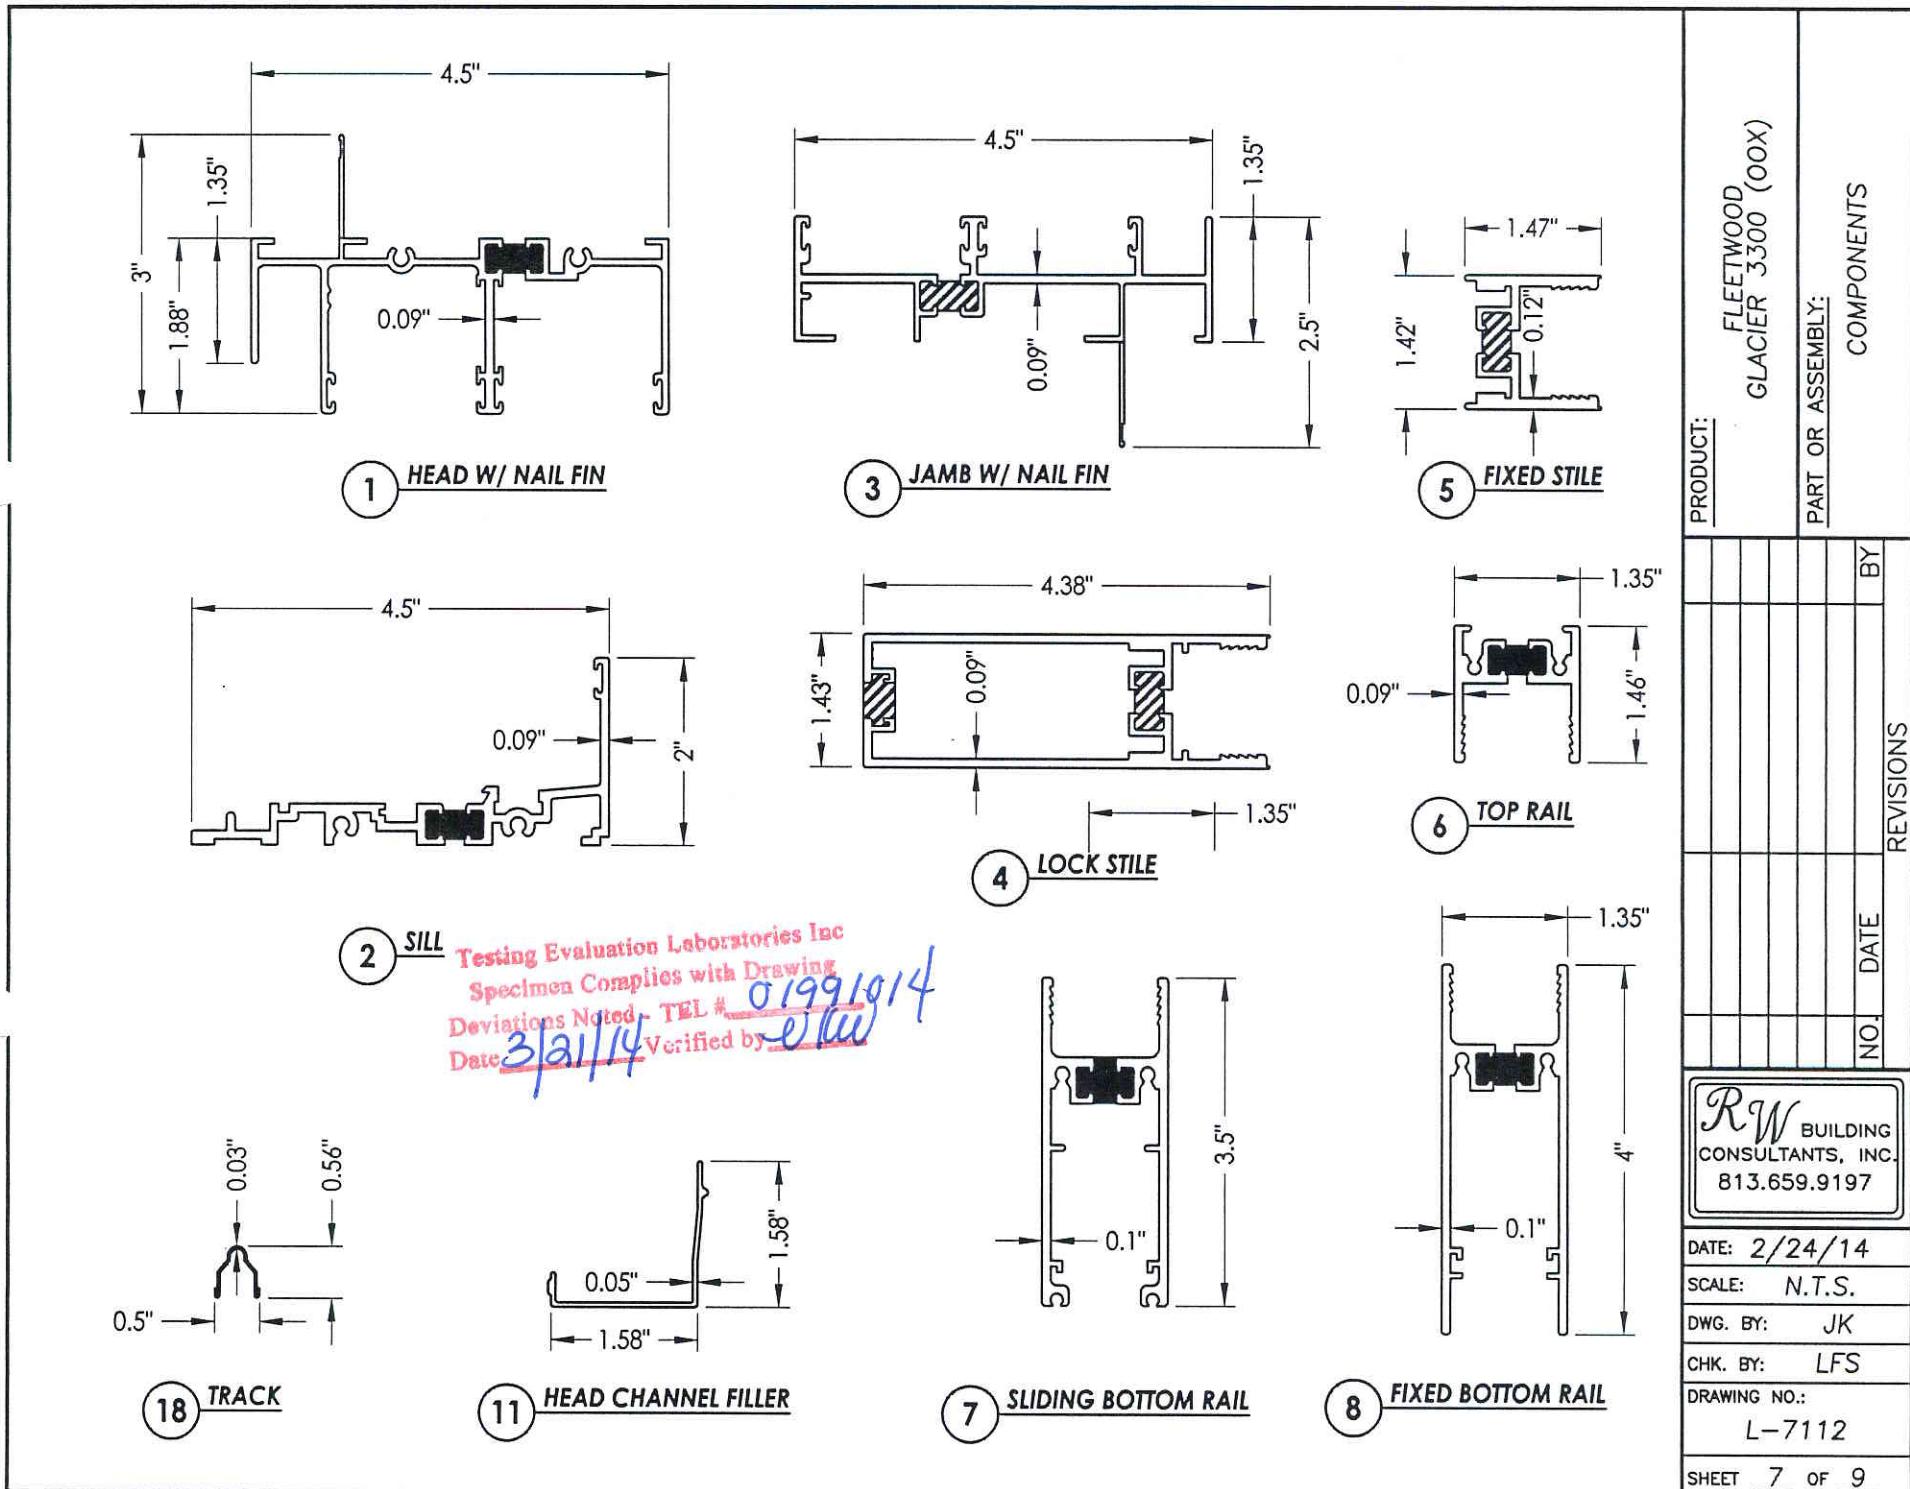


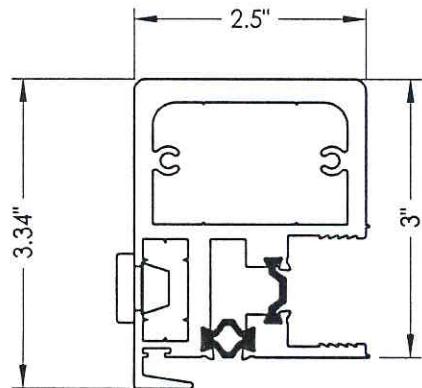


9 HP INTERLOCK

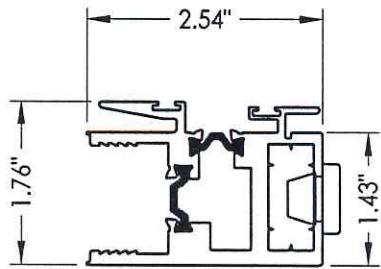

10 FIXED INTERLOCK

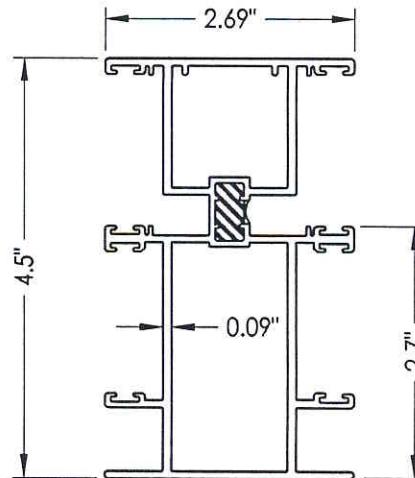

12 FALL JAMB

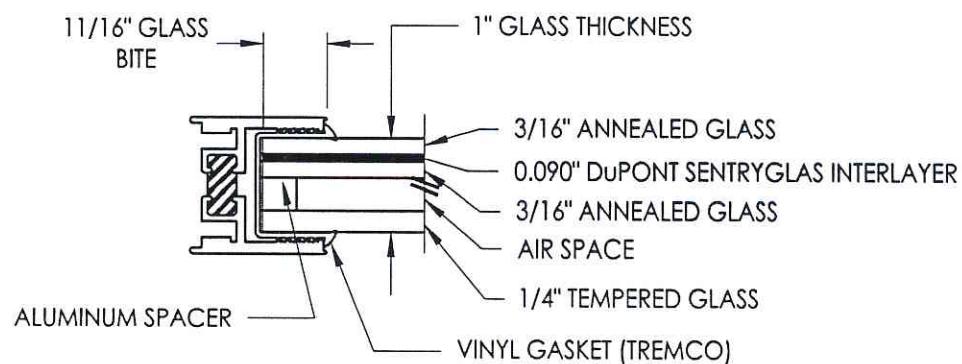

G1 GLAZING DETAIL

Testing Evaluation Laboratories Inc  
Specimen Complies with Drawing  
Deviation Noted - TEL # 0199-199  
Date 3/21/14 Certified by JK

PRODUCT:	FLEETWOOD GLACIER 3300 (00X)		
PART OR ASSEMBLY:	COMPONENTS AND GLAZING DETAIL		
BY			
REVISIONS			
NO. DATE			
<i>RW</i> BUILDING CONSULTANTS, INC. 813.659.9197			
DATE: 2/24/14			
SCALE: N.T.S.			
DWG. BY: JK			
CHK. BY: LFS			
DRAWING NO.:			
L-7112			
SHEET 8 OF 9			

## **BILL OF MATERIALS**

ITEM #	DESCRIPTION	MATERIAL
B	2X BUCK SG >= 0.42	WOOD
C	1/4" MAX. SHIM SPACE	-
F	#10 X 2" PPH SMS	STEEL
G	#10 X 2-1/2" PPH SMS	STEEL
H	#10 X 1" PFH SMS	STEEL
J	#8 X 3/4" PPH SELF-DRILLING SMS	STEEL
K	#10 X 3" PFH WS	STEEL
L	1/4-20 - 1/2" MACHINE SCREW	STEEL
1	HEAD W/ NAIL FIN	6063-T6 ALUM
2	SILL	6063-T6 ALUM
3	JAMB W/ NAIL FIN	6063-T6 ALUM
4	LOCK STILE	6063-T6 ALUM
5	FIXED STILE	6063-T6 ALUM
6	TOP RAIL	6063-T6 ALUM
7	SLIDING BOTTOM RAIL	6063-T6 ALUM
8	FIXED BOTTOM RAIL	6063-T6 ALUM
9	HP INTERLOCK	6063-T6 ALUM
10	FIXED INTERLOCK	6063-T6 ALUM
11	HEAD CLOSER	6063-T6 ALUM
12	FALL JAMB	6063-T6 ALUM
13	SLIDING BOTTOM RAIL WEATHER STRIP	-
14	LOCK STILE SPREADER	6063-T6 ALUM
15	BOTTOM RAIL SPREADER	6063-T6 ALUM
16	TOP RAIL ISOLATOR	6063-T6 ALUM
17	ISOLATOR	6063-T6 ALUM
18	S.S. TRACK	SS
19	2 FINGER VINYL	-
20	SMALL FINSEAL	-
21	LARGE FINSEAL	-
22	GLAZING VINYL 1" SCR-900, 80 DUROMETER	-
23	SILL ISOLATOR	6063-T6 ALUM
24	ROLLER ASSEMBLY	-
25	STRIKE PLATE ASSY.(JAMB)	-
26	LATCH ASSY.(JAMB)	-
32	3" X 4" L-BRACKETT	6063-T6 ALUM

Testing Evaluation Laboratories Inc  
Specimen Complies with Drawing  
Deviations Noted TEL # 0199 1014  
Date 3/21/14 Verified by Allen

PRODUCT:	FLEETWOOD GLACIER 3300 (00X)		
PART OR ASSEMBLY:			BILL OF MATERIALS
NO.	DATE	BY	REVISIONS
 <p><b>RW</b> BUILDING CONSULTANTS, INC. 813.659.9197</p>			
DATE: 2/24/14			
SCALE: N.T.S.			
DWG. BY: JK			
CHK. BY: LFS			
DRAWING NO.:			
L-7112			
SHEET <u>9</u> OF <u>9</u>			